
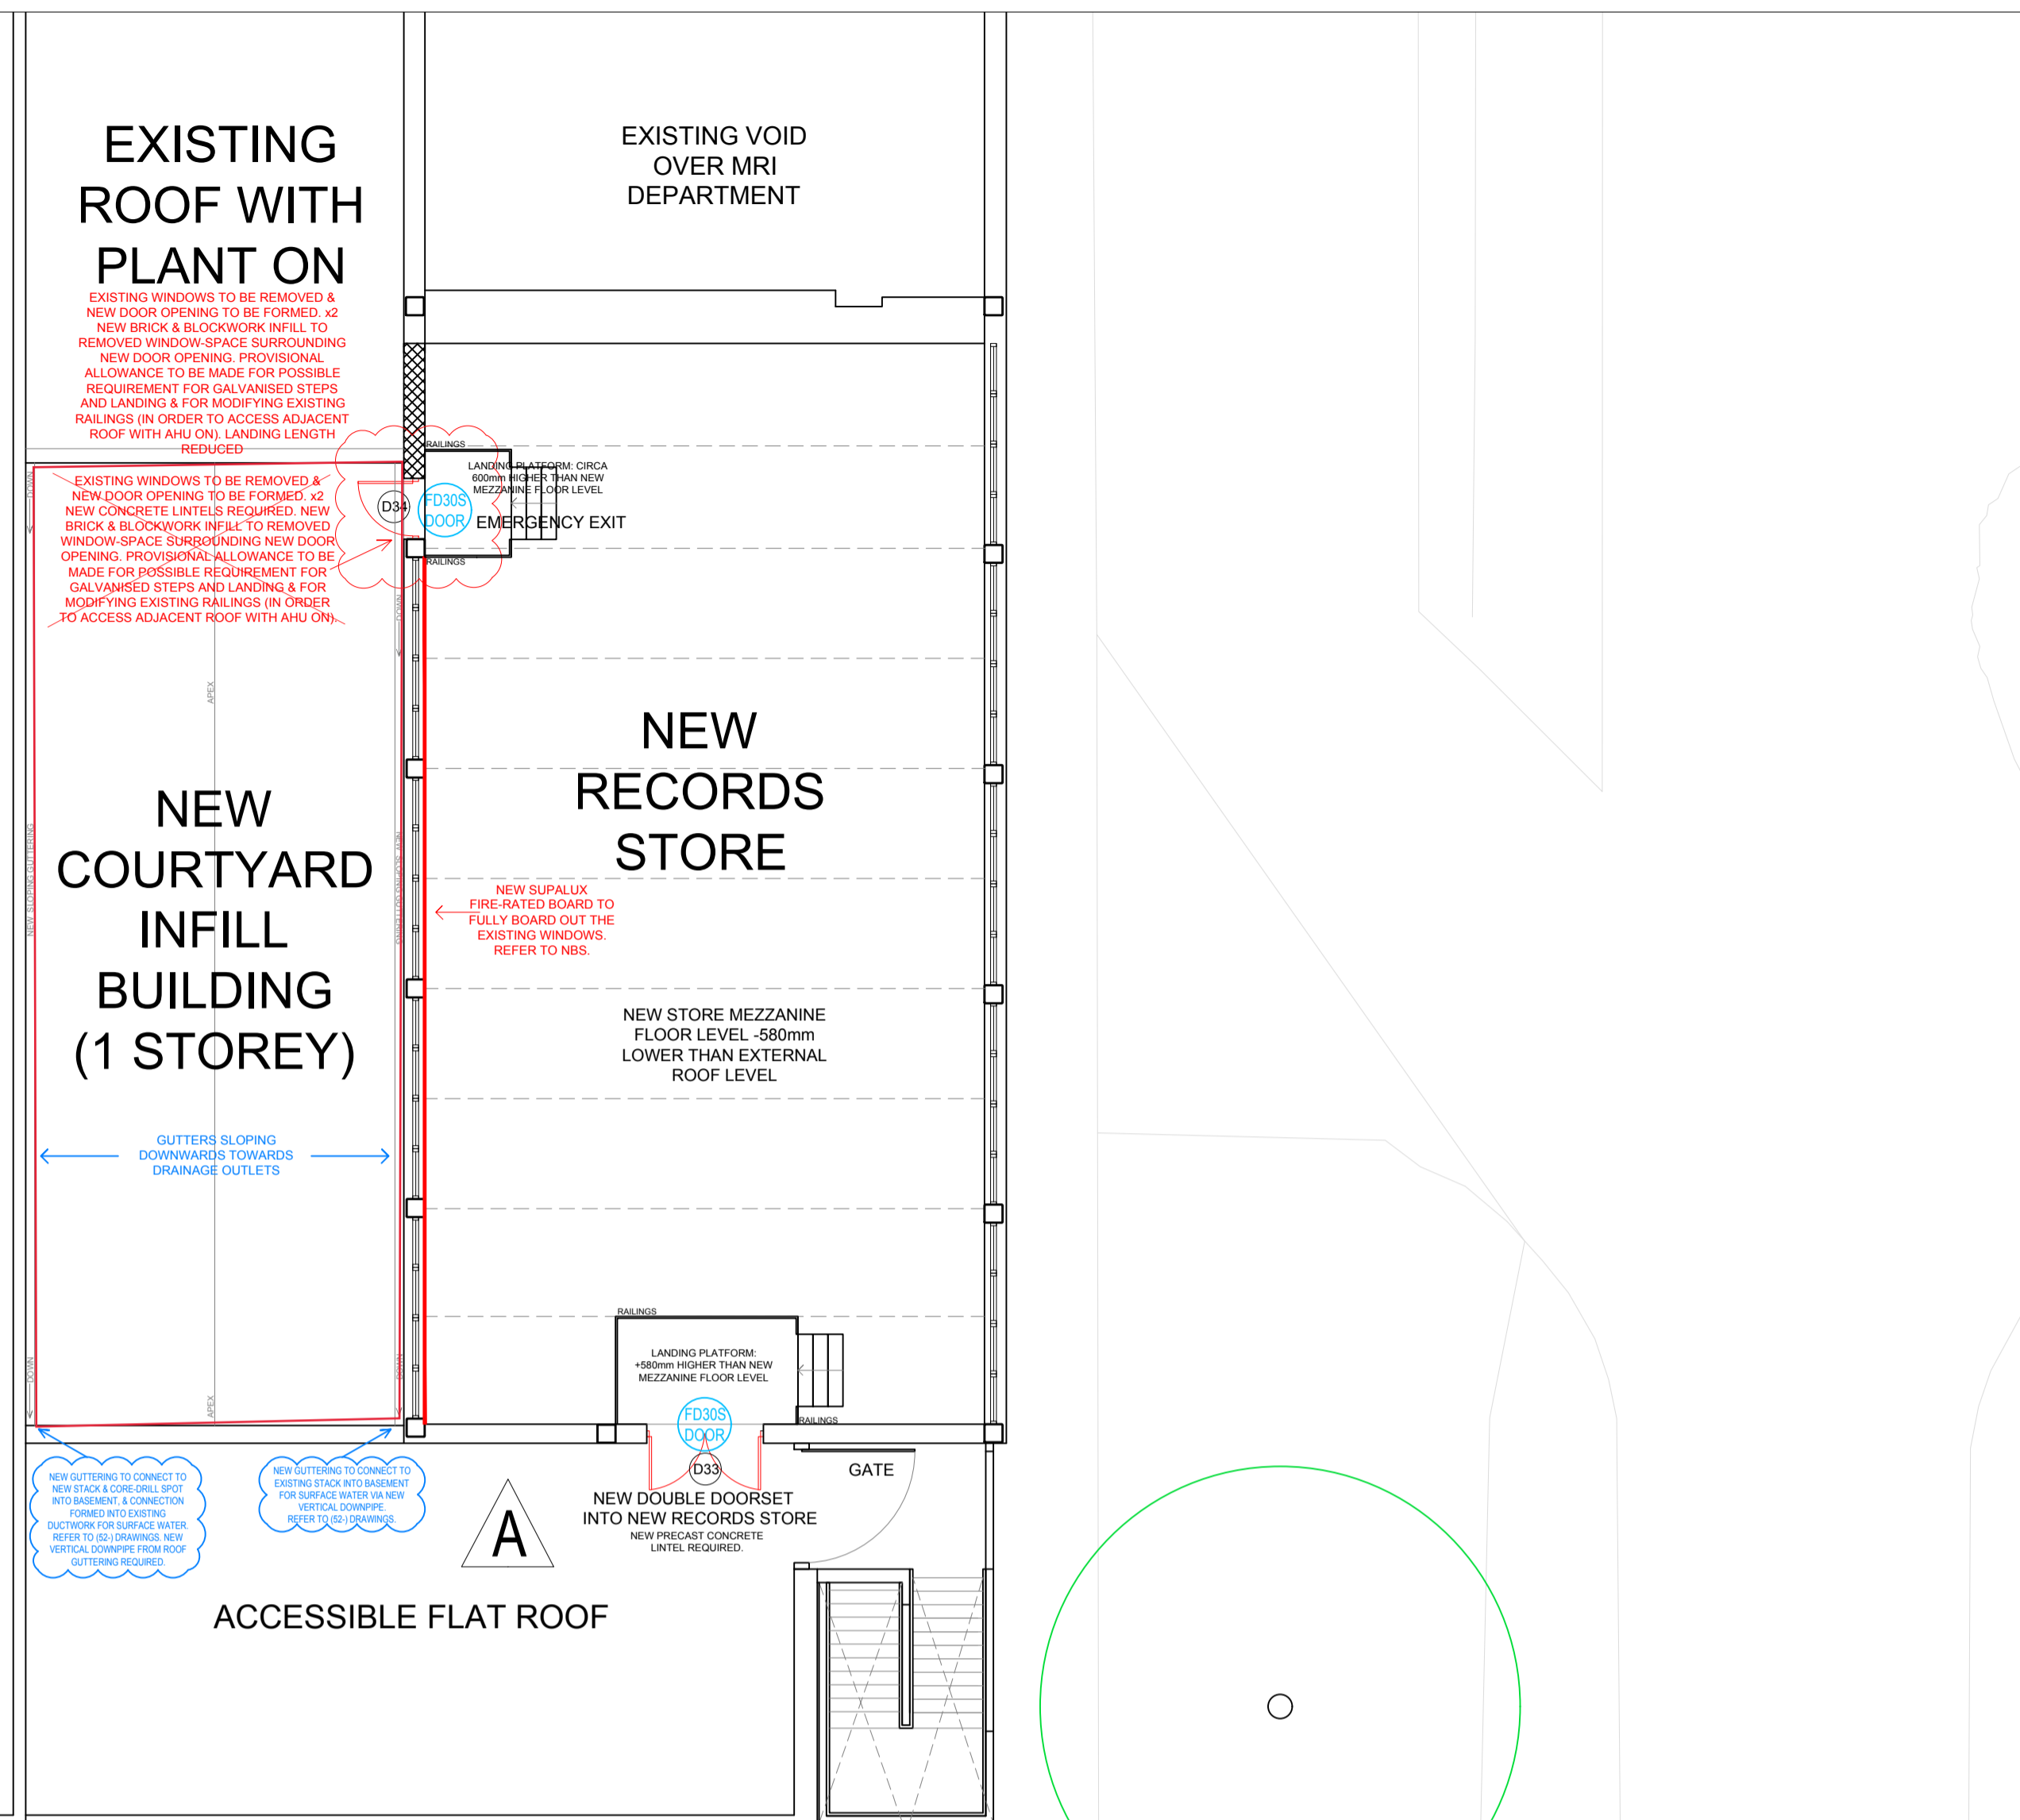


Drawing status

Notes	Status	Rev	Date
Drawn by BJ	Size A1	Scale VARIES	
PRELIMINARY STUDY	P	-	
TENDER ISSUE	T	-	09/09/20
CONSTRUCTION ISSUE	C	-	26/10/20
AMENDMENT - Steps and walkway shortened, note added	C	A	05/11/20

PROPOSED NEW RECORDS STORE MEZZANINE FLOOR PLAN  
1:100

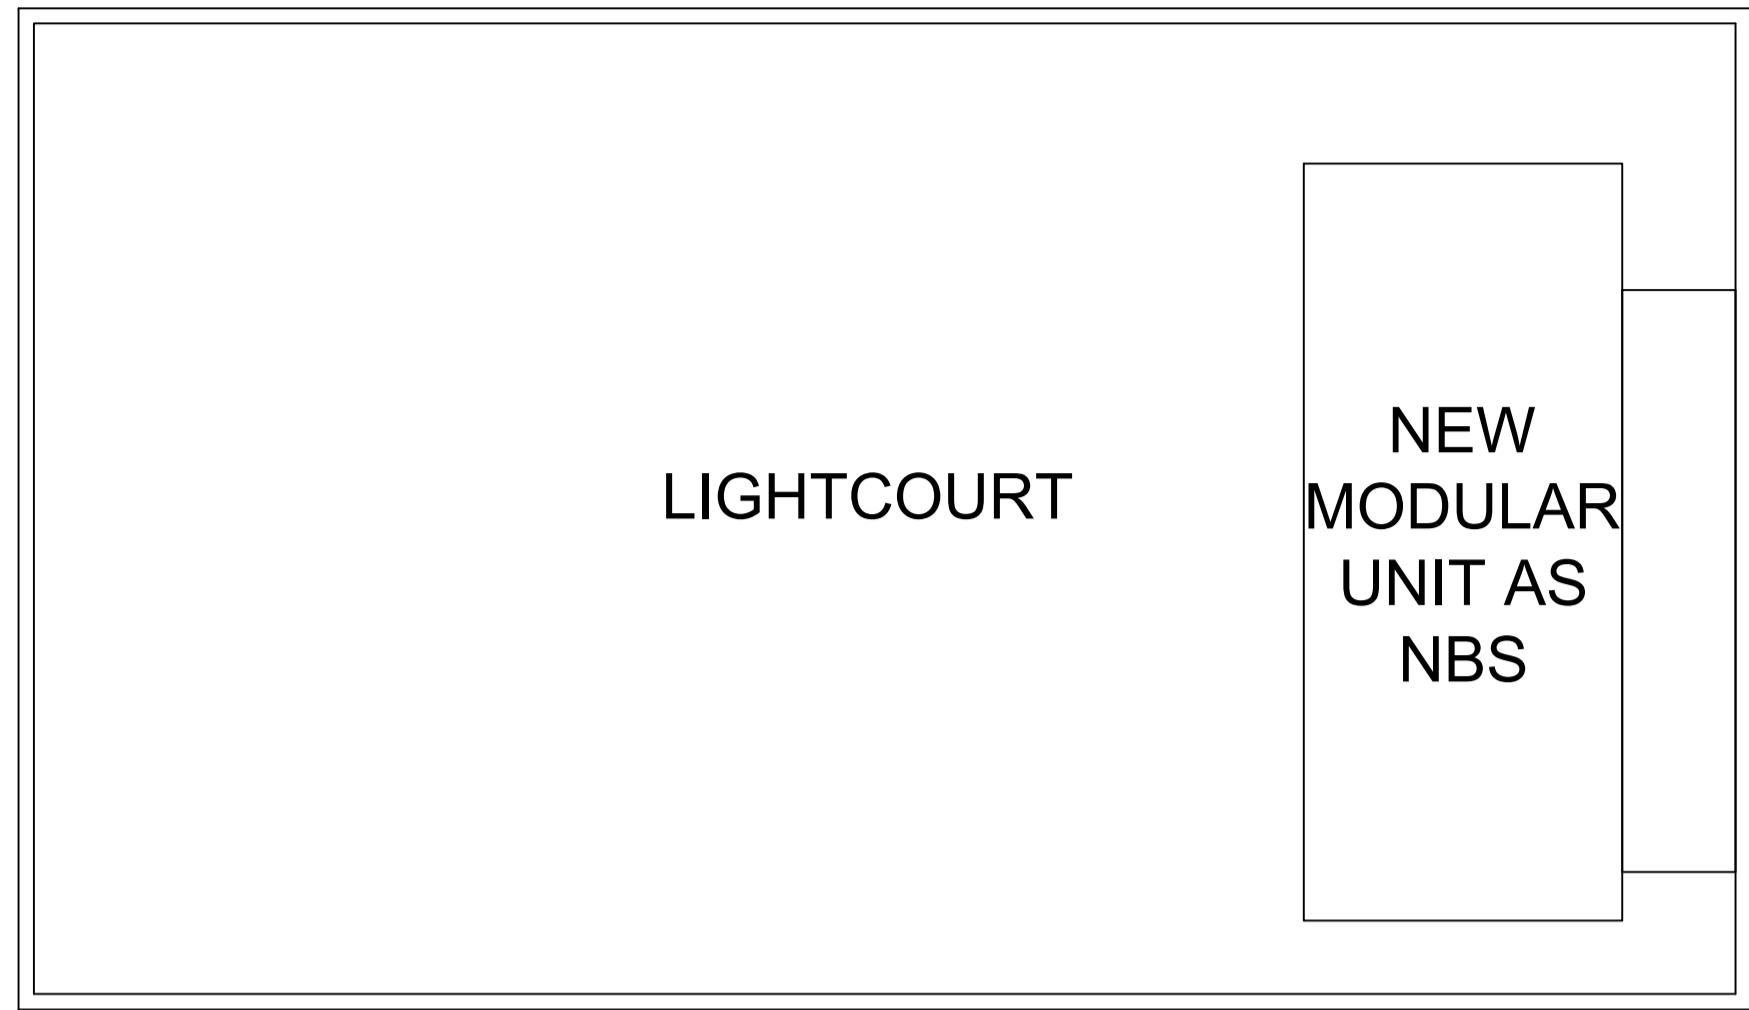

Drawing status annotation  
P-Preliminary T-Tender D-Design (post preliminary) C-Construction As-Built

Client

BARNSELY HOSPITAL NHS  
FOUNDATION TRUST

Project title

SAU AMAC PROJECT

Project no

170/028

Drawing title

MEZZANINE FLOOR RECORDS  
STORE PROPOSED PLAN  
& ELEVATION

Drawing no

(S-)04

Status Revision

C A

ELEVATION A: PROPOSED NEW RECORDS STORE END ELEVATION  
1:50

