



AS INSTALLED FRONT ELEVATION
Scale 1:50

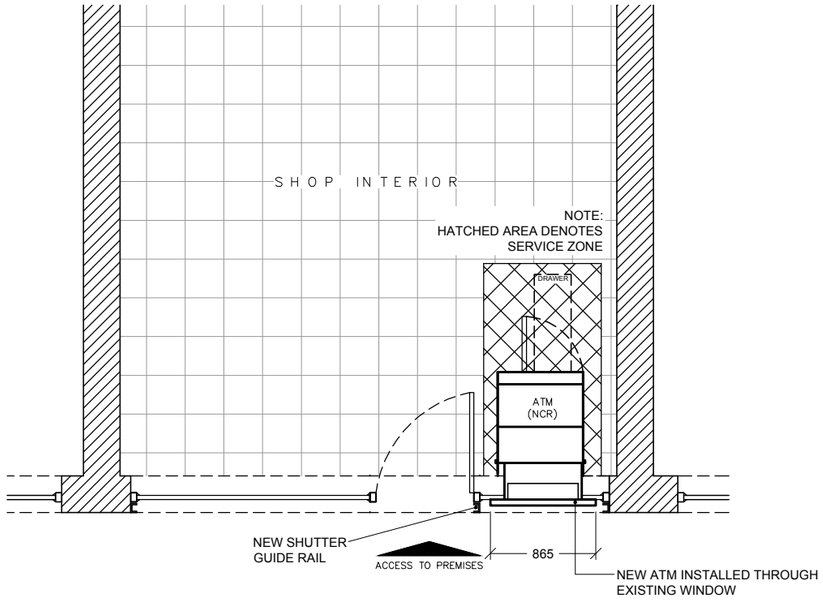

AS INSTALLED PART PLAN
Scale 1:50

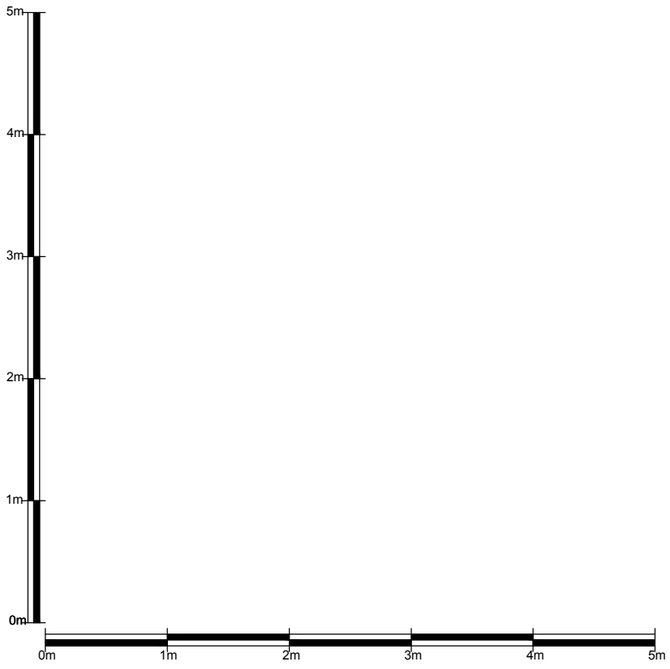

NOTE MACHINE

Date:	Comments:	By:

GENERAL NOTES:

1) All dimensions in millimeters unless otherwise stated.

Site:
KHELA FOOD & WINE

16 Doncaster Road,
Goldthorpe,
Rotherham,
S63 9HH

Drawing Title:
As Installed Elevation and Plan

Ref:	Date:	Rev:
NM-08-2015-24-2	03.08.15	
Scale: 1:50	Paper: A3	Date Rev: