
SIGN 1 1 NO. SINGLE SIDED MONOLITH SIGN

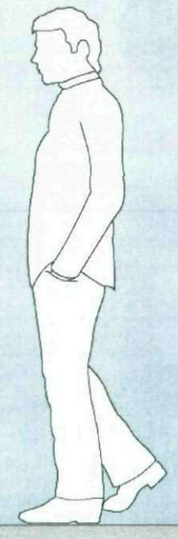

3550mm


TENANT NAMES TO BE SUPPLIED



SIGN CONSTRUCTION

Sign to consist of an internal steel support structure with extended legs for ground entry. The steel structure is to be clad to the exterior with sheet aluminium folded to form suitable depth returns. Panel faces and returns and steel structure to have a polyester powder coat paint finish. Graphic detail is to be applied to the panel face in exterior grade adhesive vinyl


SIGN 2 2 NO. SINGLE SIDED DIRECTIONAL MONOLITH SIGNS

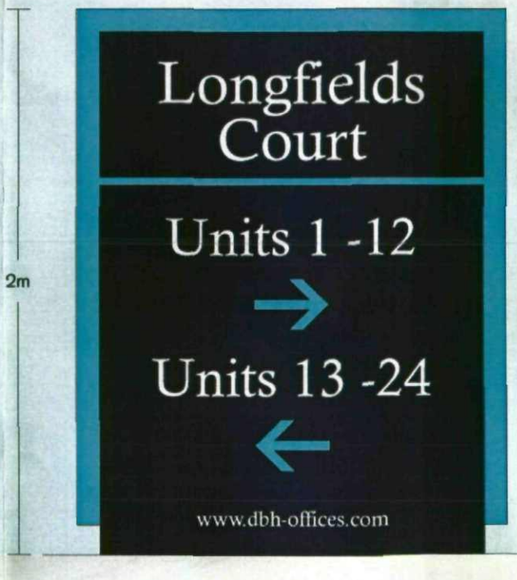


SIGN CONSTRUCTION

Sign to consist of an internal steel support structure with extended legs for ground entry. The steel structure is to be clad to the exterior with sheet aluminium folded to form suitable depth returns. Panel faces and returns and steel structure to have a polyester powder coat paint finish. Graphic detail is to be applied to the panel face in exterior grade adhesive vinyl

PLAN VIEW

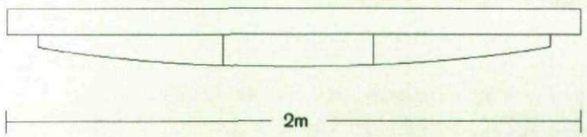

PLAN VIEW

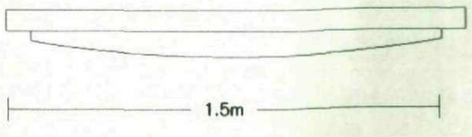

SCALE 1:20 @A3

PROJECT	**E8997 LONGFIELDS COURT**
CLIENT	**CUBE**
DRAWING NO	**1**
VERSION	**1**
DATE	**03/09/08**
DRAWN BY	**PWG**

CONSTRUCTION

COLOUR RES

- MACTAC 9829-00
- MACTAC 9839-23/RAL 5003
- MACTAC 9839-41/5012

CONCEPT SIGN AND DISPLAY LTD

Unit 320, Fort Dunlop, Fort Parkway, Birmingham B24 9FD TEL: 0121 693 0005 FAX: 0121 747 3602 EMAIL: signs@conceptsigns.co.uk © 2008 Copyright Notice. No part of this drawing may be photocopied or otherwise reproduced without written permission from Concept Sign & Display Ltd.

Barnsley Metropolitan Borough Council
18 NOV 2008
Corporate Mail Room



This drawing to be read in conjuction with all specifications and all relevant Structural Engineers, Service Engineers and Specialist Drawings.

Ref	Date	Description
ZA	05-06-07	Treatment to adjoining landscape strip and outer fence notes added.
Z	02-06-08	As built
Y	14-05-08	Retaining wall removed, Boundary amended, Elect Pillar added, Gas Governor indicated. Gates amended.
X	18-03-08	Redrawn
W	13-10-07	Building B moved back to original position.
V	27-09-07	Building B moved
U	25-09-07	Site boundary re-introduced
T	03-09-07	Principle guide levels & Channels added.
S	14-08-07	Recycling areas indicated .
R	09-08-07	Street lighting affected by works highlighted
Q	26-07-07	Unit numbers changed
P	21-06-07	Entrance revised to highway development control comments
N	13-04-07	Revision of entrance kerb west side due to property boundary.
M	22-03-07	Site boundary amended.
L	23-02-07	Building B amended. Boundary amended
K	30-11-06	Sub-station removed.
J	14-08-06	Site design amended for new site boundaries.
H	02-06-06	Notes added. Entrance gates indicated. Substation indicated. Refuse stores added. Bicycles area indicated. Office entrance paving slabs indicated. Car parking near Units 23 amended.
G	10-04-06	Building C amended.
F	16-03-06	Building C amended.
E	09-02-06	Units 21-22-23 internal layout amended. Office block re-designed, position and size changed. Site layout changed to suit new office block. Landscape amended.
D	20-01-06	Rabbit Unit removed. Units 21-22 & 23 added. Car parking amended.

Revisions

Wharncliffe Business Park. Barnsley

Client: **Northern Office Investments Ltd.**

Description: **Site Layout**

13/01/06 | Revision ZA

1: 200 | **1447:01**

Barnsley Metropolitan Borough Council
18 NOV 2008
Corporate Mail Room

Robin Clayton Partnership
Chartered Architects + Planning Consultants
9 Union Court Castle Street Liverpool L2 4SJ
Tel: 0151 236 8353 Fax: 0151 236 3926

Divisions in border are 10m @ 1:100

Copyright reserved Robin Clayton Partnership Ltd ©

For Setting Out refer to Drawing 1447#27

Site Boundaries.
These have been shown after reference to dimensions provided by Renaissance South Yorkshire and by site survey (Formby Survey 2006) and instructions provided by CUBE Property Surveyors. Red line boundary amended by client instructions. 22-03-2007 and as directed by employer 14-08-2007