

Rev.	Date	Description
A	NOV 19	MINOR UPDATE FOLLOWING COMMENTS FROM CLIENT
B	JAN 20	W02&3 CHANGED TO RETAIN EXISTING WINDOW WITH INTERNAL SECONDARY GLAZING
C	FEB 20	UPDATED INLINE WITH BUILDING CONTROL QUERIES
D	APR 20	UPDATED FOR TENDER CLARIFICATION AND IN ACCORDANCE WITH CLIENT INSTRUCTIONS.
E	JUL 20	VELUXS OMITTED. CONSERVATION AREA ROOF LIGHTS ADDED
F	JUL 20	BICYCLE STORES ADDED

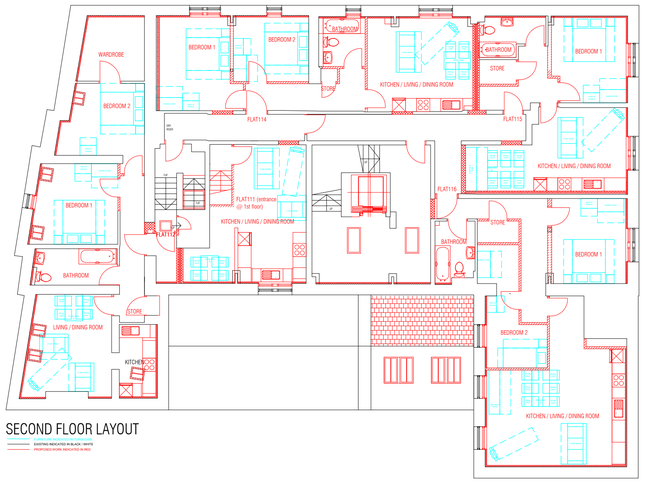


SECOND FLOOR LAYOUT

EXISTING INDICATED IN BLACK / WHITE
PROPOSED WORK INDICATED IN RED

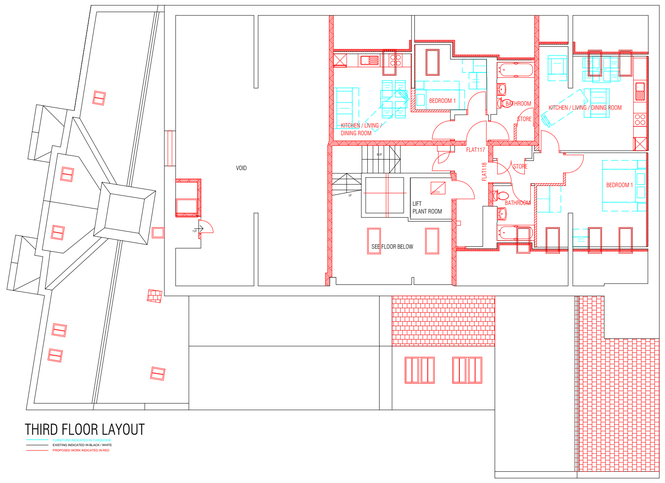

THIRD FLOOR LAYOUT

EXISTING INDICATED IN BLACK / WHITE
PROPOSED WORK INDICATED IN RED

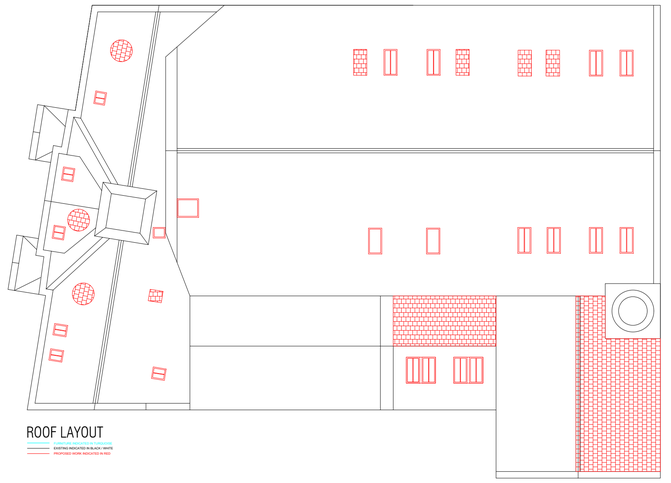


ROOF LAYOUT

EXISTING INDICATED IN BLACK / WHITE
PROPOSED WORK INDICATED IN RED



GROUND FLOOR LAYOUT

EXISTING INDICATED IN BLACK / WHITE
PROPOSED WORK INDICATED IN RED

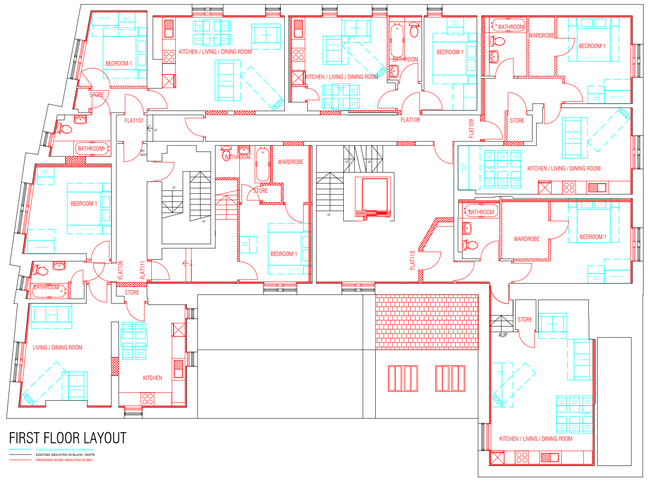

FIRST FLOOR LAYOUT

EXISTING INDICATED IN BLACK / WHITE
PROPOSED WORK INDICATED IN RED

Arcus Consulting LLP
Wakefield 0192 466 9000
Liverpool 0151 708 1080
info@arcus.uk.com
Manchester 0161 905 3222
Newcastle 0191 272 5781
www.arcus.uk.com
London 0208 8742 2512
Rugby 01788 297 127

Client
RIVERSIDE
-

Project
BEDSITS TO FLATS
HOLDEN HOUSE, 2 RACE STREET, BARNSLEY, S70 1BG

Title
PROPOSED
ALL LAYOUTS

Scale	Date	Stage
1:100 @ A0	NOV 19	WORKING DWG
Job No	Drawing No	Rev
6078	207	AS INDICATED
Drawn	Approved	
NW	LA	

This drawing is the copyright of Arcus. Contractors must check all dimensions on site. Do not scale the drawings.Only figured dimensions are to be worked to.