

PLEASE FIND ENCLOSED
OVERHEAD LINE (2009 EXEMPTION)
CORRESPONDENCE.

BEST REGARDS



WITH COMPLIMENTS

CRAIG DIXON - GOODE

NORTHERN POWERGRID

is the trading name of Northern Powergrid (Northeast) Limited (Registered No: 2906593) and Northern Powergrid (Yorkshire) plc (Registered No: 4112320)

Registered Office: Lloyds Court, 78 Grey Street, Newcastle upon Tyne NE1 6AF. Registered in England and Wales.

If you would like an audio copy of this letter or a copy in large type, Braille or another language, please call 0800 169 7602.

www.northernpowergrid.com

THIS FORM IS FOR USE BY ELECTRICITY NETWORK OPERATORS TO ADVISE LOCAL PLANNING AUTHORITIES OF PROPOSED WORKS TO BE UNDERTAKEN WITHIN THEIR DESIGNATED AREA THAT ARE CONSIDERED TO BE EXEMPTED UNDER THE OVERHEAD LINES (EXEMPTION) (ENGLAND AND WALES) REGULATIONS 2009. LOCAL AUTHORITIES HAVE THE RIGHT TO INVOKE THE FULL SECTION 37 PROCESS UNDER THE ELECTRICITY ACT 1989 SHOULD IT BE CONSIDERED NECESSARY.

The Form should be sent in triplicate to each Local Planning Authority in whose area the proposed development would be situated.

Details of Applicant

Name: Northern Powergrid (Yorkshire) plc
Contact Person: Craig Dixon-Goode
Address: Northern Powergrid, 1st Floor
Unit 1, Chessingham Park
Common Road, Dunnington
York, YO19 5PD

Telephone No: 07980 343409
Applicant's Ref: CDG/YC14183

Date: 20/11/2018

To: The Chief Executive, Barnsley Metropolitan Borough Council

Electricity Act 1989: Overhead Lines (Exemption)(England and Wales) Regulations 2009


It is proposed to undertake the following work that is considered to be exempted from the Electricity Act 1989 by falling within the Overhead Lines (Exemption)(England and Wales) Regulations 2009:

Overhead Line Replacement - Barugh to Elmhirst Lane 66,000 Volt Line, South Yorkshire

Particulars of proposed development to be completed by Applicant:

We propose to undertake the works as shown on the enclosed plans numbered CDG1958, CDG1959 and CDG1960 that are considered to be exempted from the Electricity Act 1989 by falling within the Overhead Lines (Exemption)(England and Wales) Regulations 2009. These works involve the replacement of conductors, a new section of 66,000 Volt overhead line and a significant amount of the existing line being replaced by a design successor specification overhead line. This work will allow us to remove 17 wood house masts and 11 spans of 66,000 overhead line improving both the aesthetic of the locality and the resilience of our network.

The Council/Authority is requested to indicate that it has no objection to the work being carried out by returning two copies of this Form with the Certificate completed and signed.

 

CERTIFICATE

**TO BE COMPLETED BY THE LOCAL PLANNING AUTHORITY AND RETURNED TO
THE APPLICANT ELECTRICITY NETWORK COMPANY WITHIN SIX WEEKS OF
RECEIPT**

Barnsley Metropolitan Borough Council

(i) objects/does* not object for the proposed development detailed above to be undertaken under the exemptions laid down in the Overhead Lines (Exemption)(England and Wales) Regulations

(ii) wishes/does* not wish the Secretary of State to consider the application using the full section 37 process under the Electricity Act 1989.


The reasons for requesting the full section 37 process are*:

Signed: _____ Dated: _____
Designation: _____
on behalf of **Barnsley Metropolitan Borough Council**

**delete as appropriate*


Applicant's Reference: CDG/YC14183

SCHEME Barugh to Elmhirst Lane 66kV Line, South Yorkshire					PROJECT No. YP14183
LEGEND	VOLTAGE	EXISTING	PROPOSED	TO BE REMOVED	
OVERHEAD LINE					
UNDERGROUND CABLE					
SUPPORT POSITIONS					
STAYS					
STRUTS					
SCALE 1:5000		OS PLAN No. 431098,407811 PLAN No. CDG1958			
Based upon the Ordnance survey with the sanction of the controller of H.M. Stationery Office.					

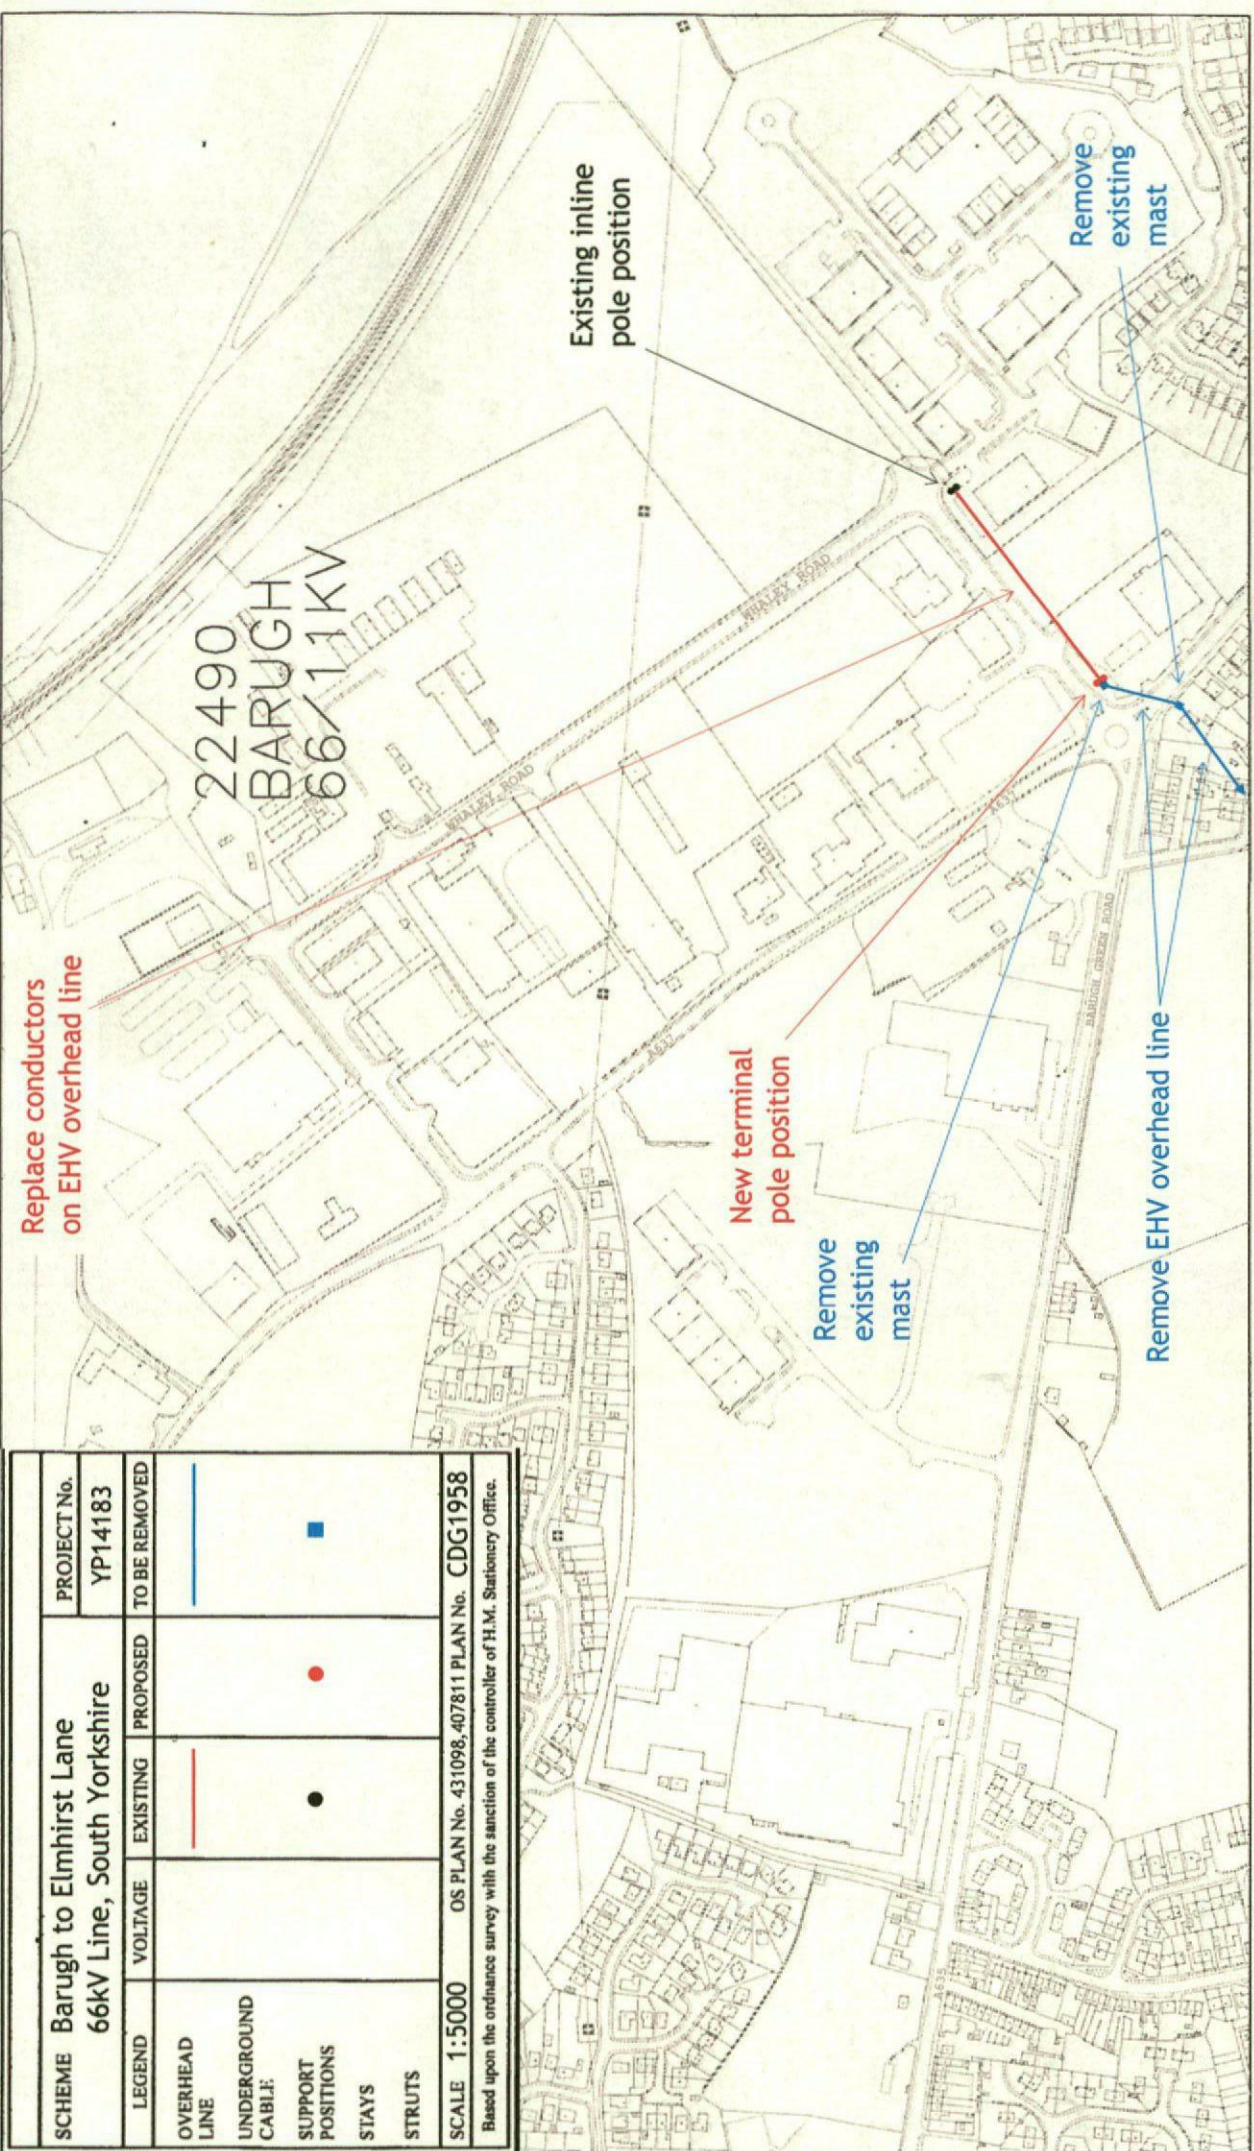


Northern Powergrid Holdings Company	Ad-hoc	14-11-2018
		1:5000
	431098,407811	CAS2

SCHEME Barugh to Elmhirst Lane .66kV Line, South Yorkshire				PROJECT No. YP14183
LEGEND	VOLTAGE	EXISTING	PROPOSED	TO BE REMOVED
OVERHEAD LINE		—	—	—
UNDERGROUND CABLE				
SUPPORT POSITIONS		■	●	■
STAYS				
STRUTS				
SCALE 1:5000 OS PLAN No. 430920,406721 PLAN No. CDG1959				
Based upon the ordnance survey with the sanction of the controller of H.M. Stationery Office.				

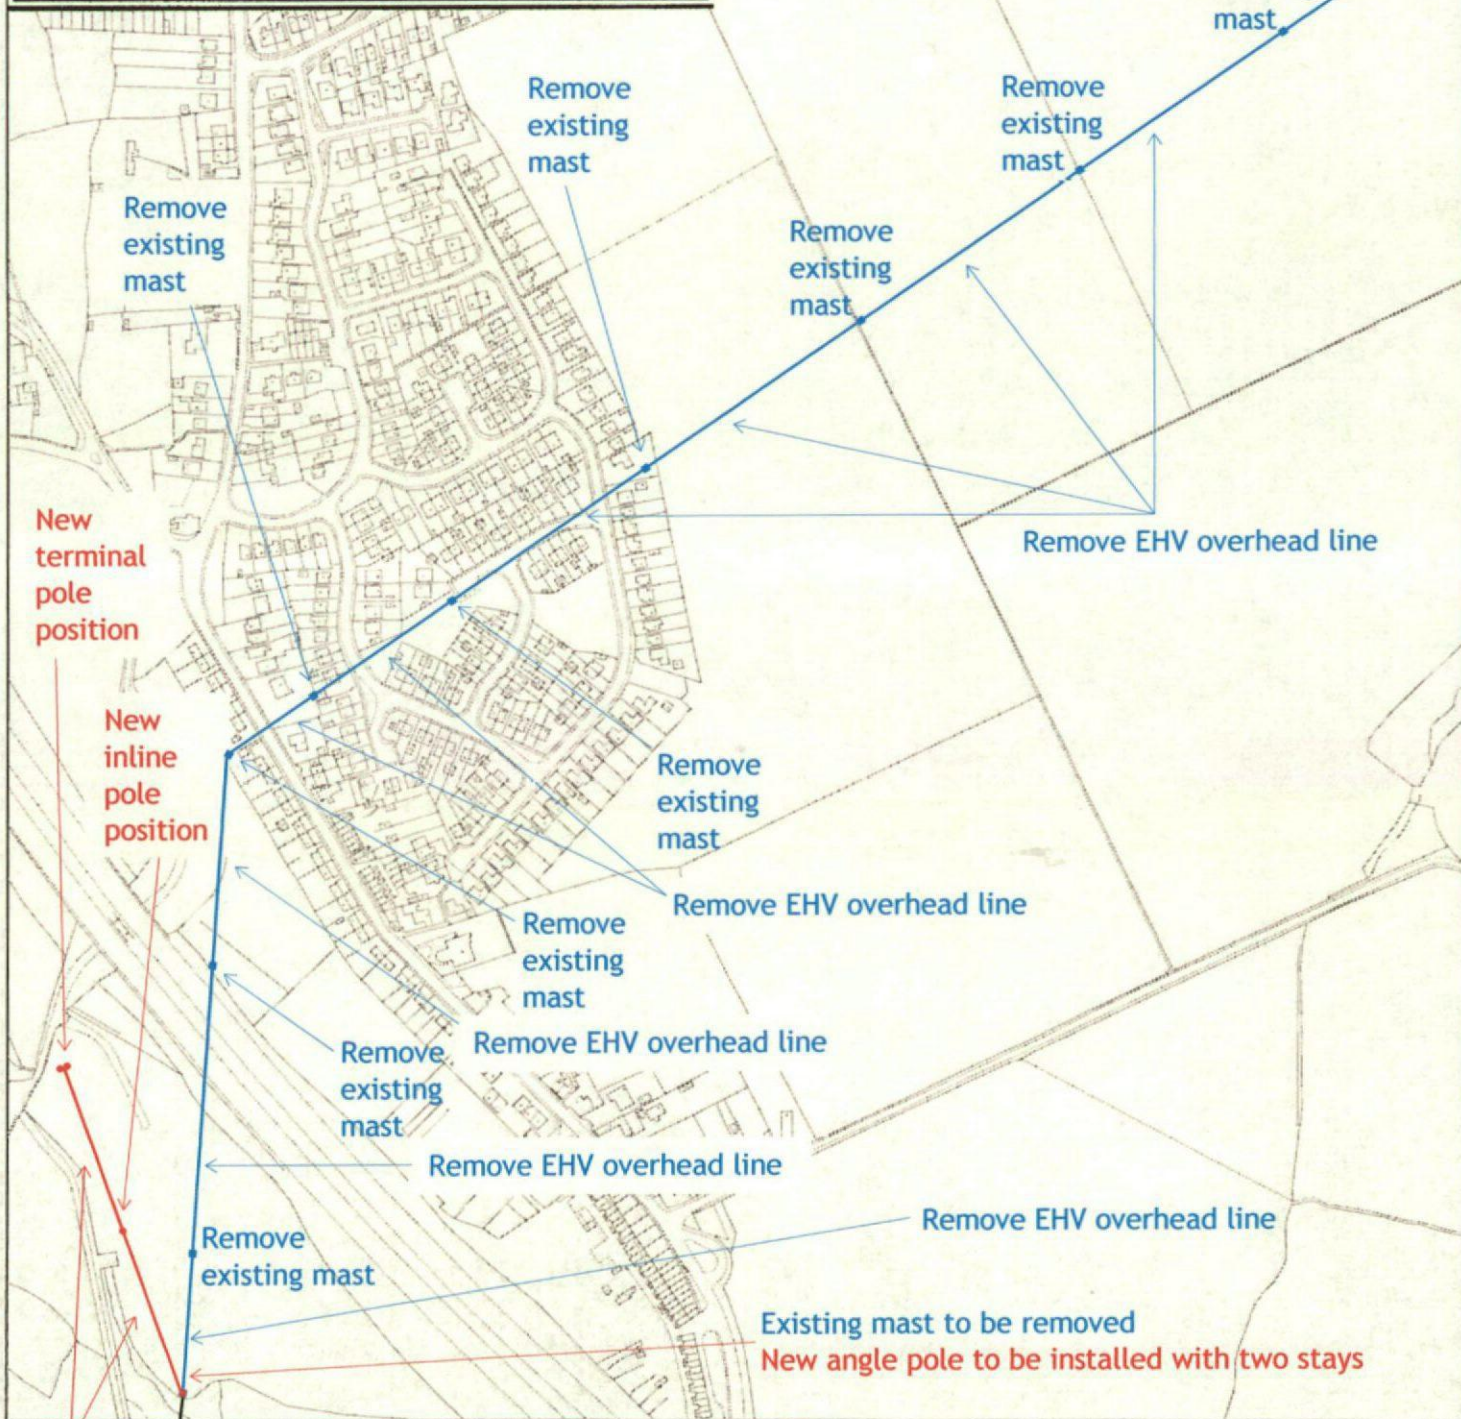

New EHV
overhead line

Northern Powergrid Holdings Company	Ad-hoc	14-11-2018
	430920,406721	1:5000
		CAS2

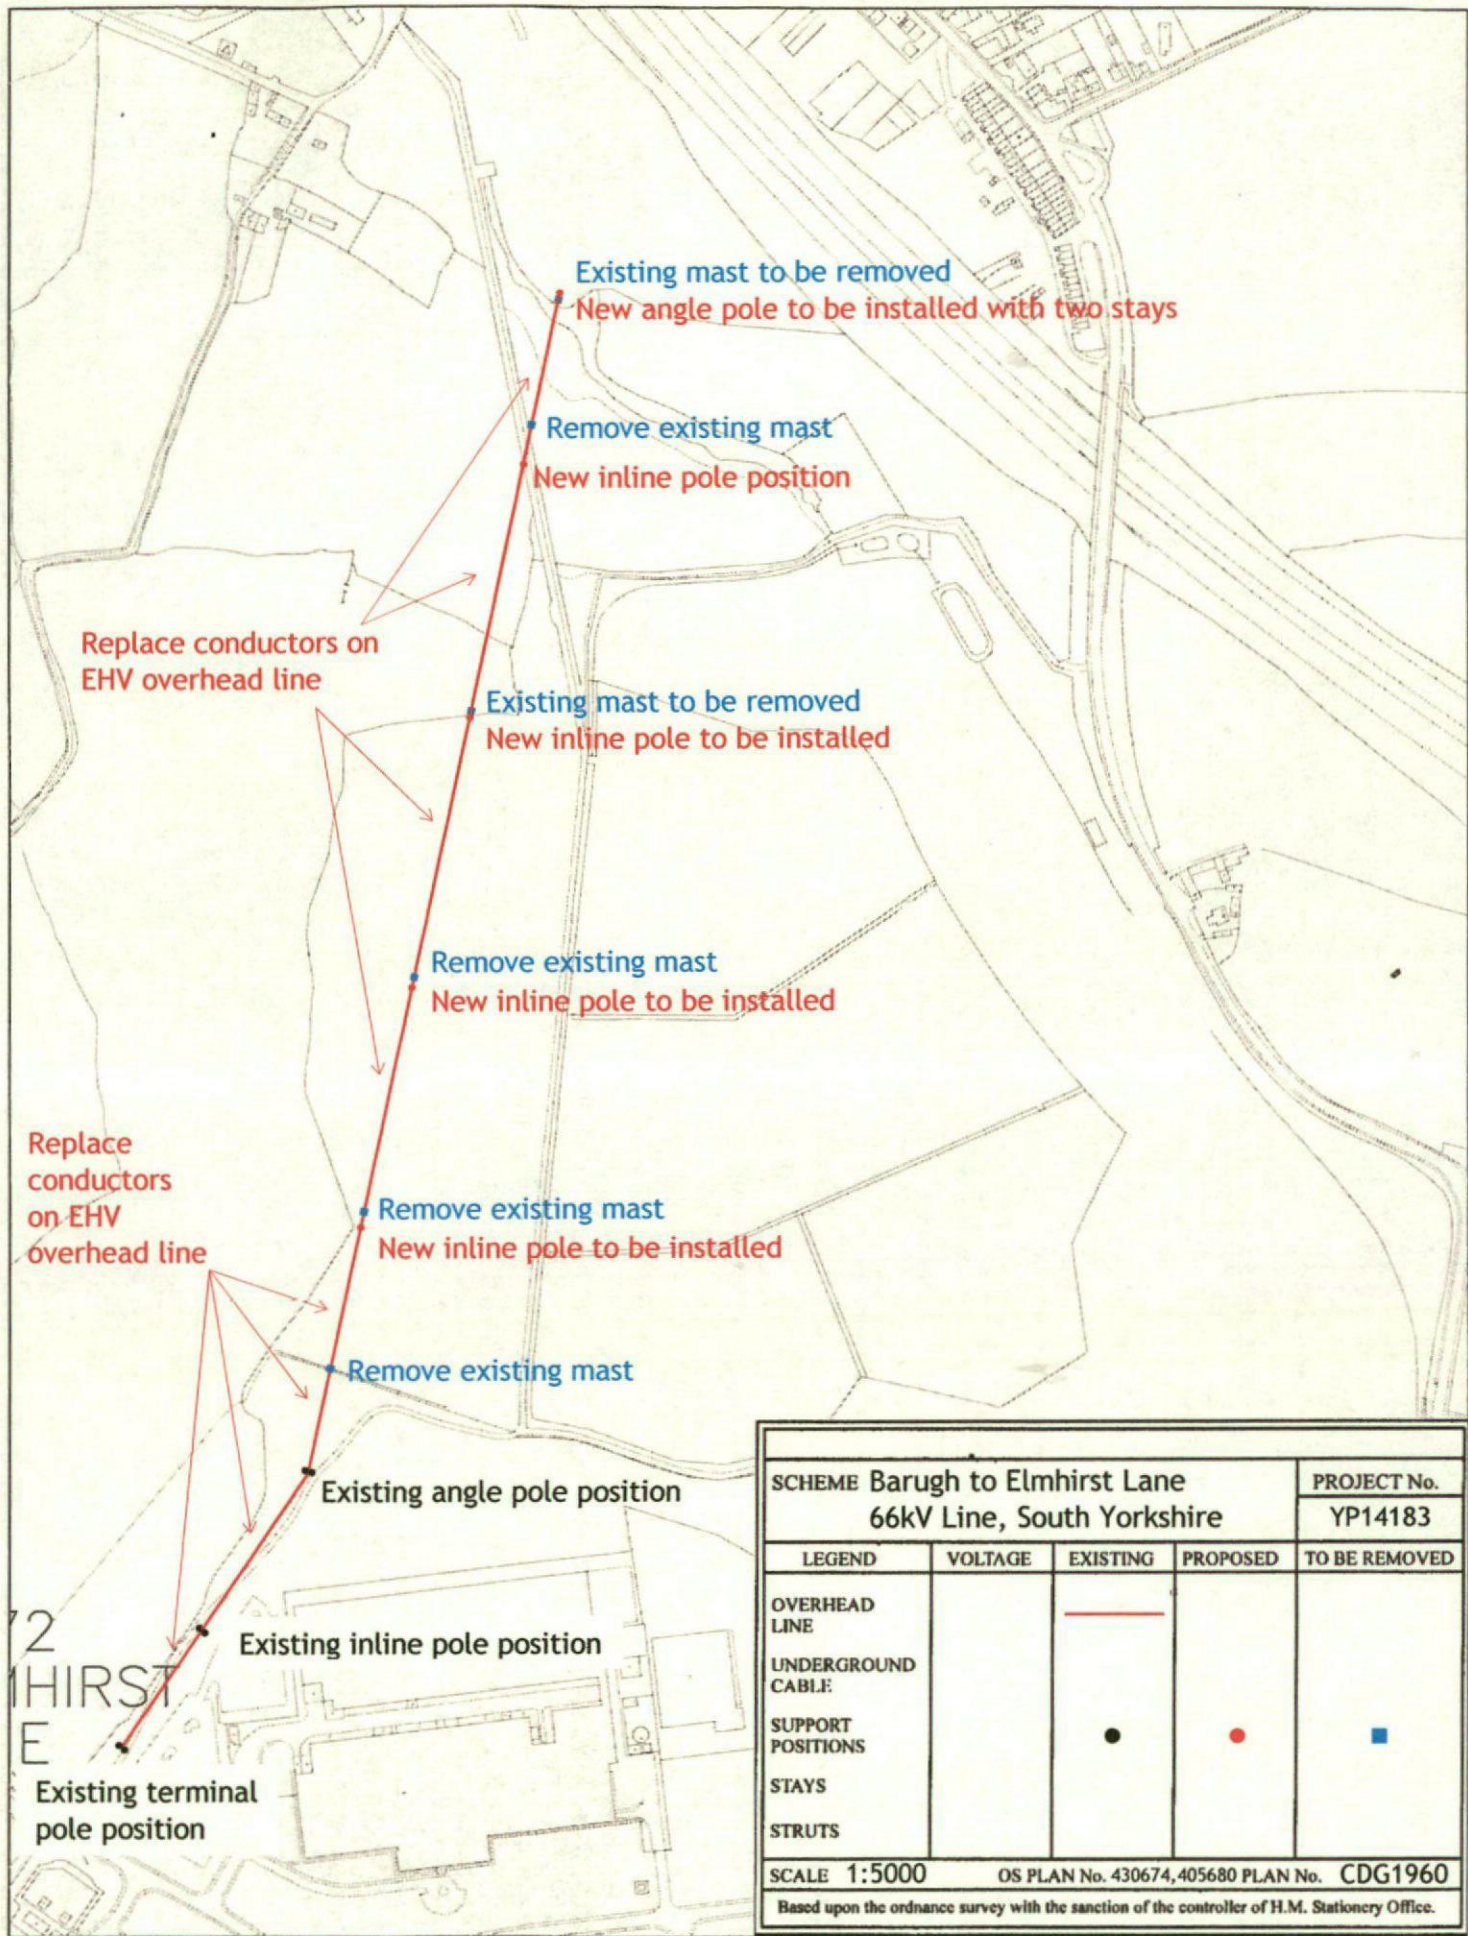

SCHEME Barugh to Elmhirst Lane 66kV Line, South Yorkshire				PROJECT No. YP14183
LEGEND	VOLTAGE	EXISTING	PROPOSED	TO BE REMOVED
OVERHEAD LINE				
UNDERGROUND CABLE				
SUPPORT POSITIONS				
STAYS				
STRUTS				
SCALE 1:5000		OS PLAN No. 430674,405680 PLAN No. CDG1960		
Based upon the ordnance survey with the sanction of the controller of H.M. Stationery Office.				

Northern Powergrid Holdings Company	Ad-hoc	14-11-2018
		1:5000
	430674,405680	CAS2

THIS FORM IS FOR USE BY ELECTRICITY NETWORK OPERATORS TO ADVISE LOCAL PLANNING AUTHORITIES OF PROPOSED WORKS TO BE UNDERTAKEN WITHIN THEIR DESIGNATED AREA THAT ARE CONSIDERED TO BE EXEMPTED UNDER THE OVERHEAD LINES (EXEMPTION) (ENGLAND AND WALES) REGULATIONS 2009. LOCAL AUTHORITIES HAVE THE RIGHT TO INVOKE THE FULL SECTION 37 PROCESS UNDER THE ELECTRICITY ACT 1989 SHOULD IT BE CONSIDERED NECESSARY.

The Form should be sent in triplicate to each Local Planning Authority in whose area the proposed development would be situated.

Details of Applicant

Name: Northern Powergrid (Yorkshire) plc
Contact Person: Craig Dixon-Goode
Address: Northern Powergrid, 1st Floor
Unit 1, Chessingham Park
Common Road, Dunnington
York, YO19 5PD

Telephone No: 07980 343409
Applicant's Ref: CDG/YC14183

Date: 20/11/2018

To: The Chief Executive, Barnsley Metropolitan Borough Council

Electricity Act 1989: Overhead Lines (Exemption)(England and Wales) Regulations 2009

It is proposed to undertake the following work that is considered to be exempted from the Electricity Act 1989 by falling within the Overhead Lines (Exemption)(England and Wales) Regulations 2009:


Overhead Line Replacement - Barugh to Elmhirst Lane 66,000 Volt Line, South Yorkshire

Particulars of proposed development to be completed by Applicant:

We propose to undertake the works as shown on the enclosed plans numbered CDG1958, CDG1959 and CDG1960 that are considered to be exempted from the Electricity Act 1989 by falling within the Overhead Lines (Exemption)(England and Wales) Regulations 2009. These works involve the replacement of conductors, a new section of 66,000 Volt overhead line and a significant amount of the existing line being replaced by a design successor specification overhead line. This work will allow us to remove 17 wood house masts and 11 spans of 66,000 overhead line improving both the aesthetic of the locality and the resilience of our network.

The Council/Authority is requested to indicate that it has no objection to the work being carried out by returning two copies of this Form with the Certificate completed and signed.

Yours Faithfully

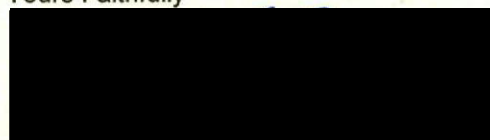

For and on behalf of the Applicant

CERTIFICATE

**TO BE COMPLETED BY THE LOCAL PLANNING AUTHORITY AND RETURNED TO
THE APPLICANT ELECTRICITY NETWORK COMPANY WITHIN SIX WEEKS OF
RECEIPT**

Barnsley Metropolitan Borough Council

(i) objects/does* not object for the proposed development detailed above to be undertaken under the exemptions laid down in the Overhead Lines (Exemption)(England and Wales) Regulations

(ii) wishes/does* not wish the Secretary of State to consider the application using the full section 37 process under the Electricity Act 1989.


The reasons for requesting the full section 37 process are*:

Signed: _____ Dated: _____
Designation: _____
on behalf of **Barnsley Metropolitan Borough Council**

**delete as appropriate*

Applicant's Reference: CDG/YC14183


SCHEME Barugh to Elmhirst Lane 66kV Line, South Yorkshire				PROJECT No. YP14183
LEGEND	VOLTAGE	EXISTING	PROPOSED	TO BE REMOVED
OVERHEAD LINE				
UNDERGROUND CABLE:				
SUPPORT POSITIONS				
STAYS				
STRUTS				
SCALE 1:5000 OS PLAN No. 431098,407811 PLAN No. CDG1958				
Based upon the Ordnance survey with the sanction of the controller of H.M. Stationery Office.				

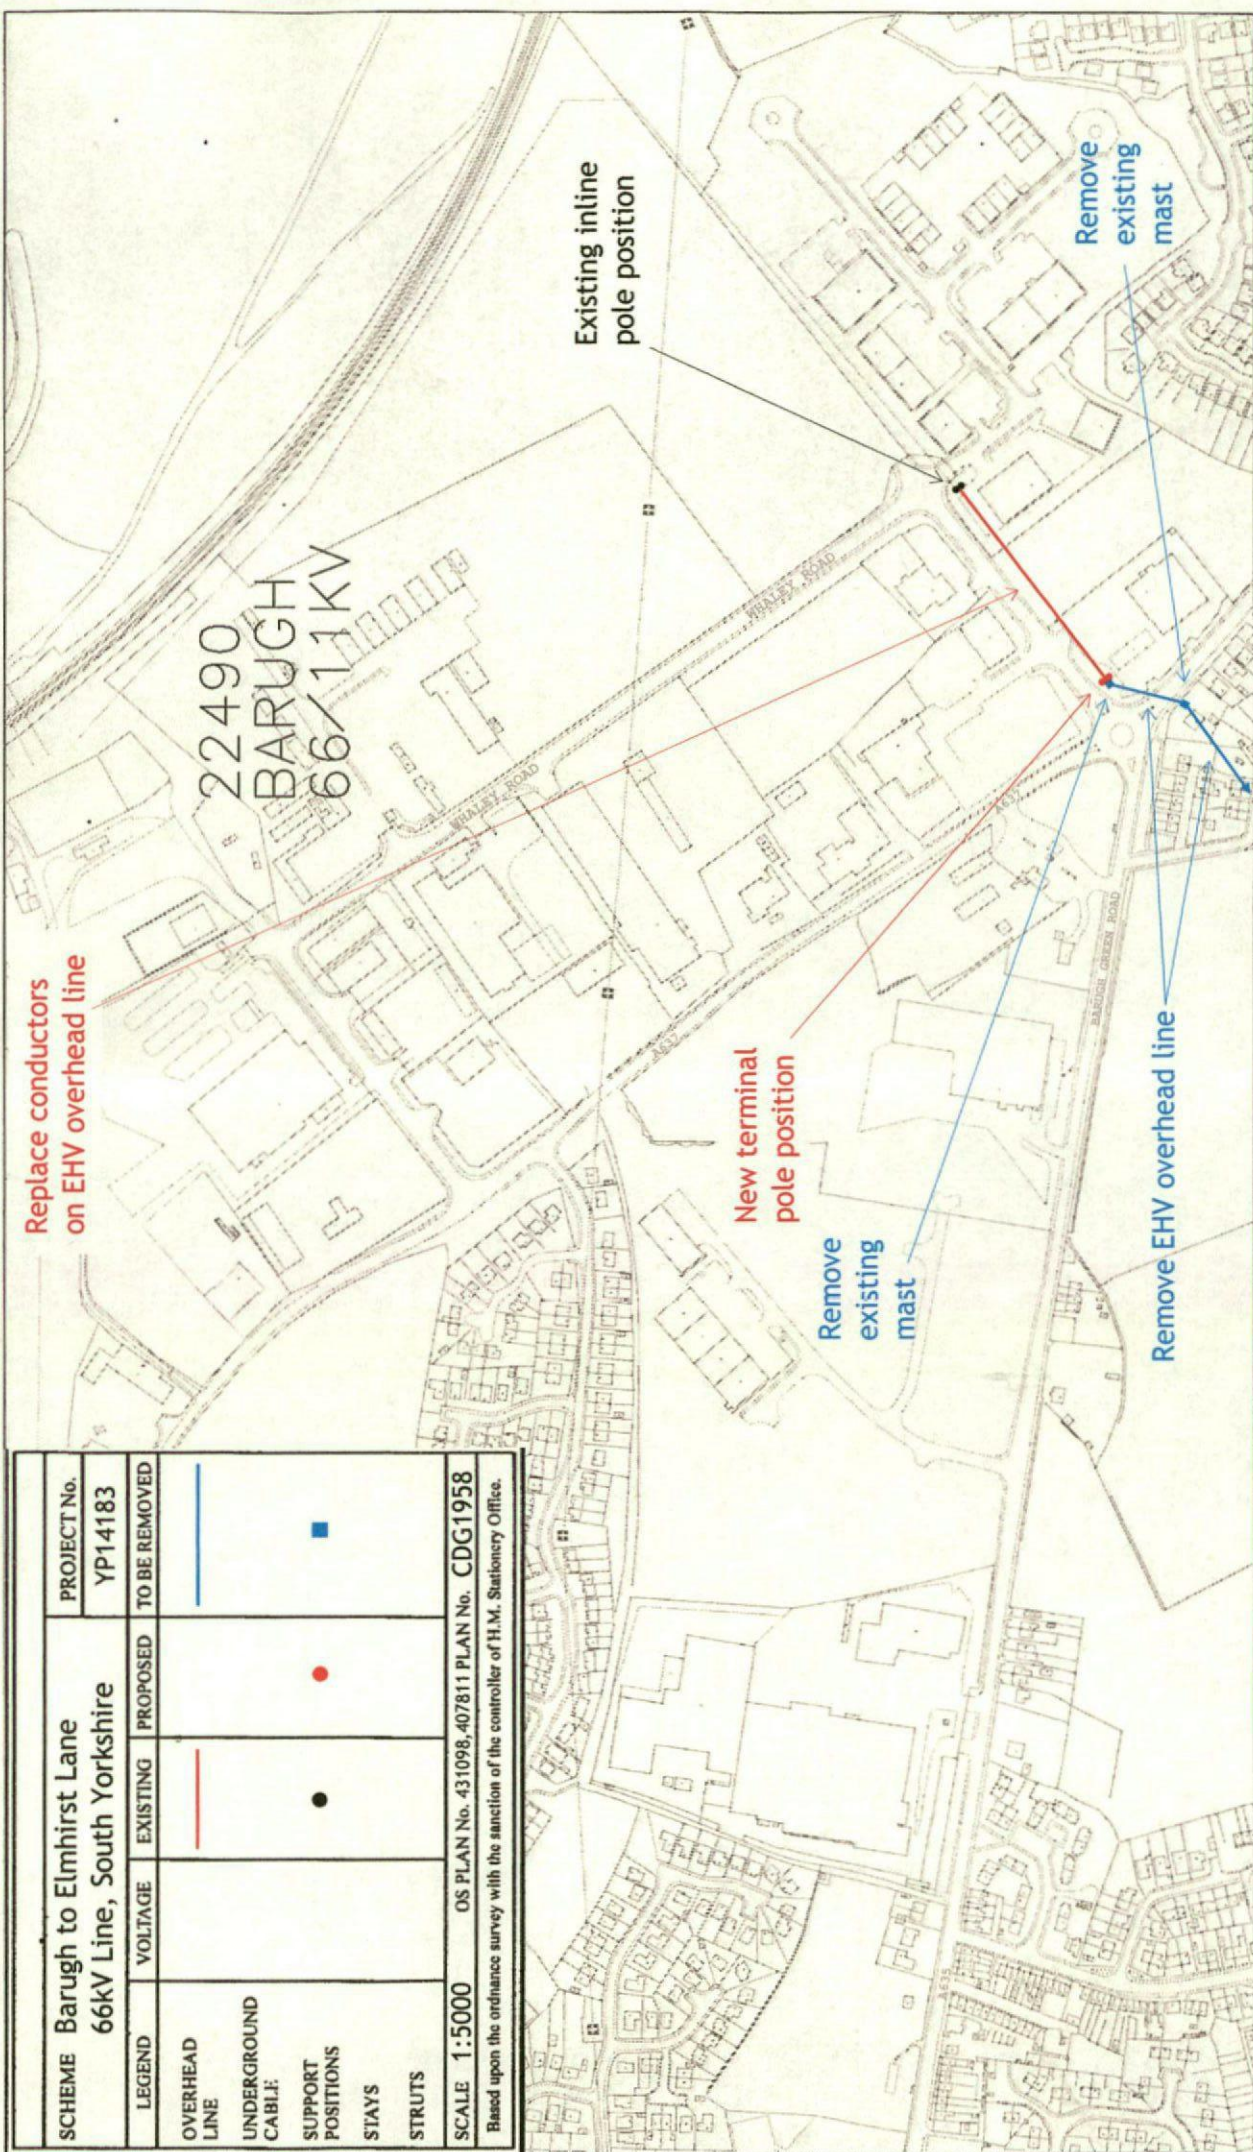

Northern Powergrid Holdings Company	Ad-hoc	14-11-2018
		1:5000
	431098,407811	CAS2



CAS2

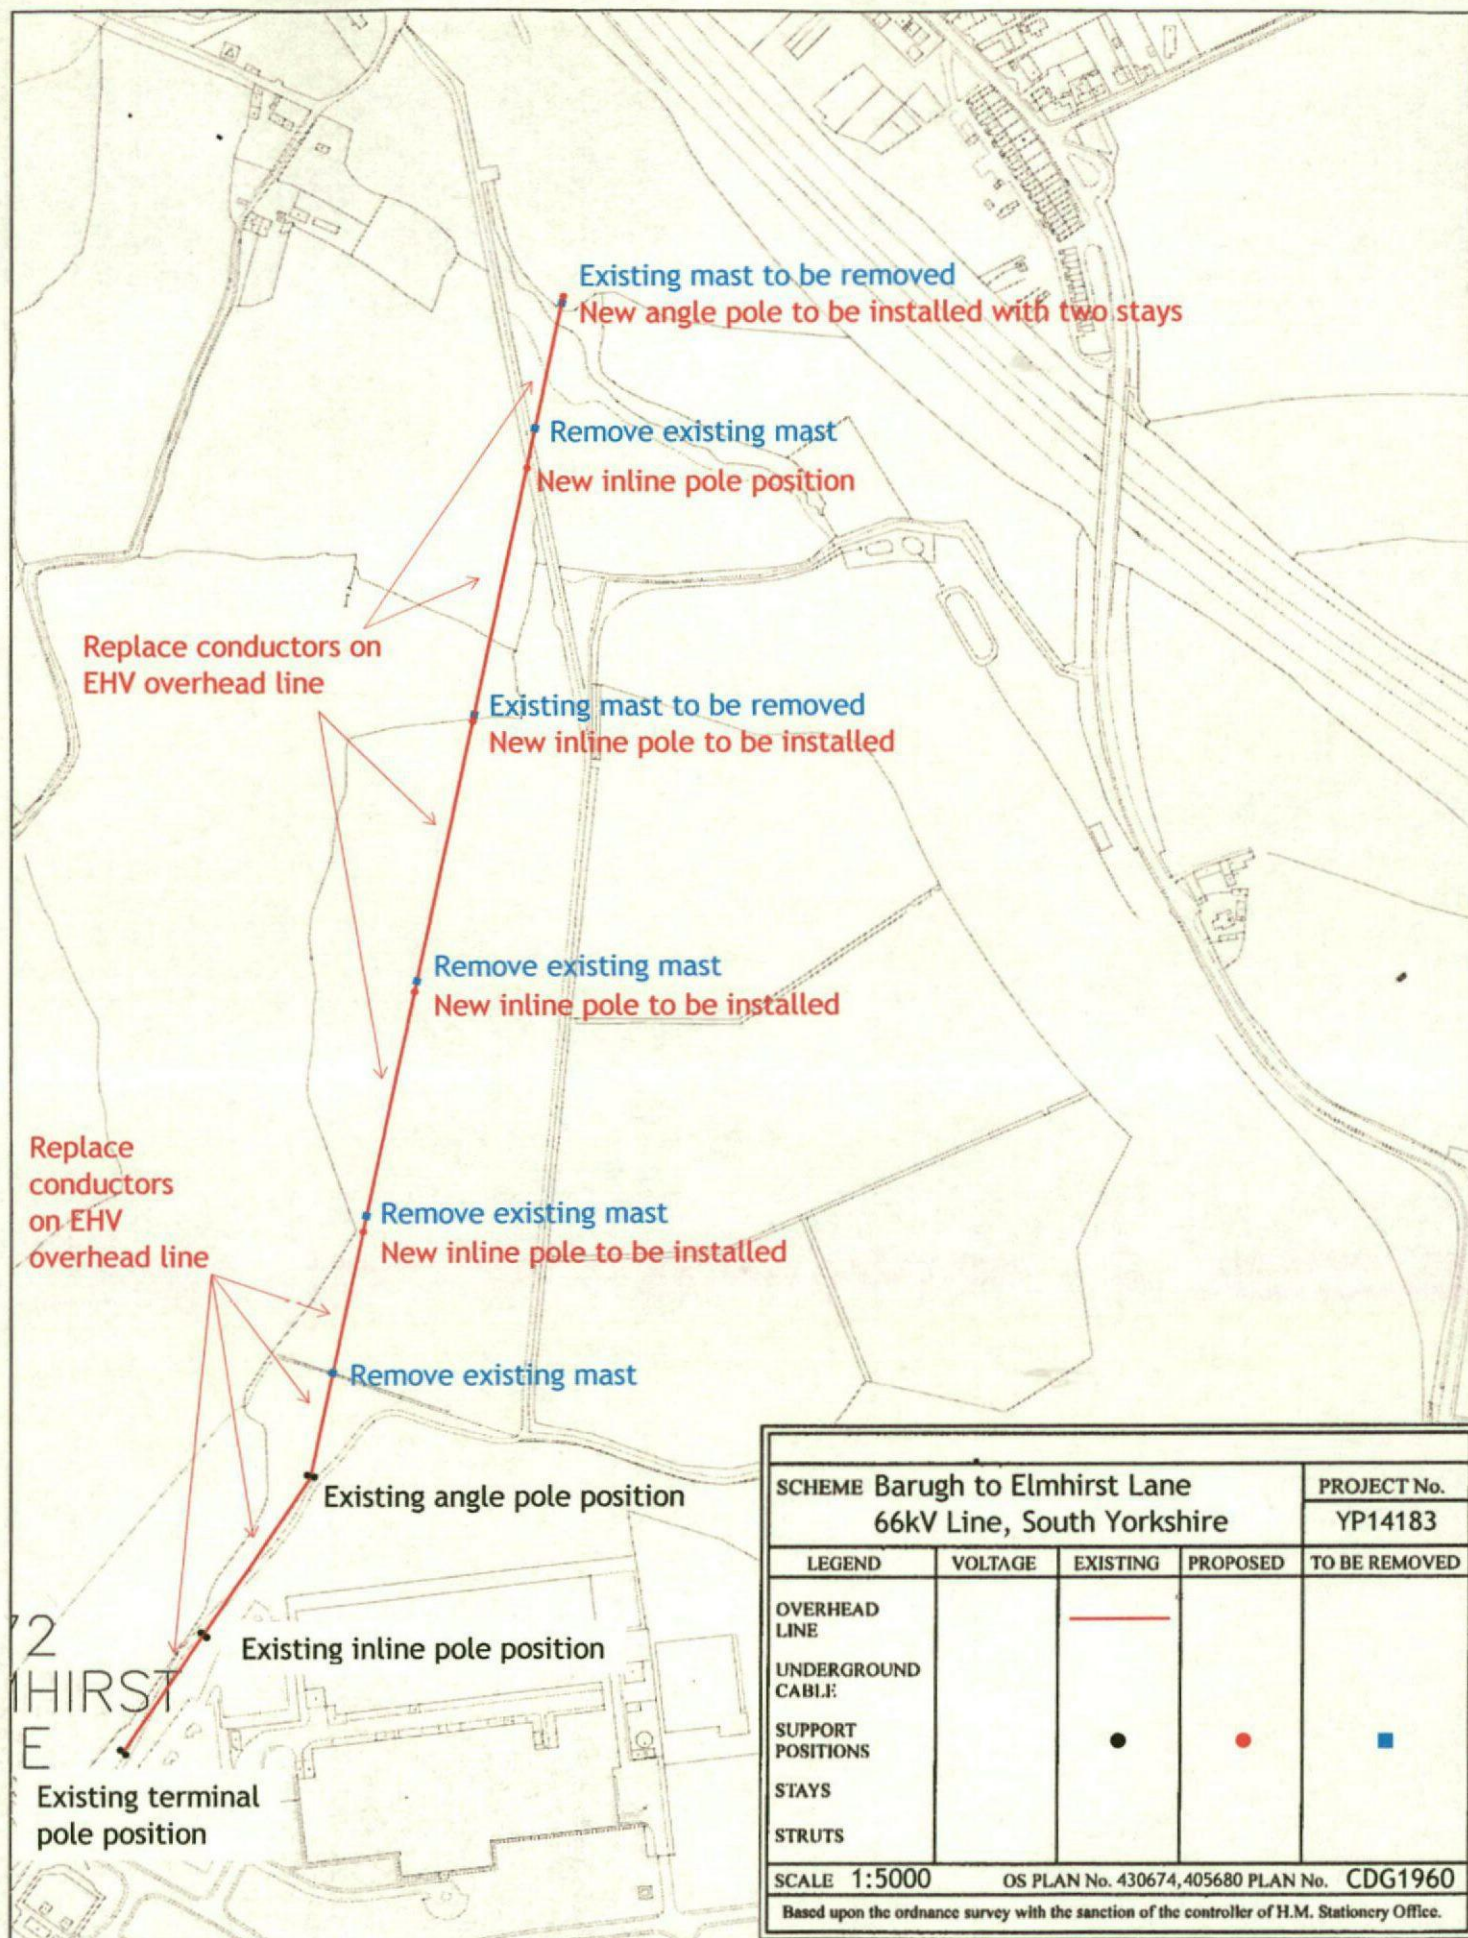

Northern Powergrid Holdings Company	Ad-hoc	14-11-2018
		1:5000
	430674,405680	CAS2

THIS FORM IS FOR USE BY ELECTRICITY NETWORK OPERATORS TO ADVISE LOCAL PLANNING AUTHORITIES OF PROPOSED WORKS TO BE UNDERTAKEN WITHIN THEIR DESIGNATED AREA THAT ARE CONSIDERED TO BE EXEMPTED UNDER THE OVERHEAD LINES (EXEMPTION) (ENGLAND AND WALES) REGULATIONS 2009. LOCAL AUTHORITIES HAVE THE RIGHT TO INVOKE THE FULL SECTION 37 PROCESS UNDER THE ELECTRICITY ACT 1989 SHOULD IT BE CONSIDERED NECESSARY.

The Form should be sent in triplicate to each Local Planning Authority in whose area the proposed development would be situated.

Details of Applicant

Name: Northern Powergrid (Yorkshire) plc
Contact Person: Craig Dixon-Goode
Address: Northern Powergrid, 1st Floor
Unit 1, Chessingham Park
Common Road, Dunnington
York, YO19 5PD

Telephone No: 07980 343409
Applicant's Ref: CDG/YC14183

Date: 20/11/2018

To: The Chief Executive, Barnsley Metropolitan Borough Council

Electricity Act 1989: Overhead Lines (Exemption)(England and Wales) Regulations 2009

It is proposed to undertake the following work that is considered to be exempted from the Electricity Act 1989 by falling within the Overhead Lines (Exemption)(England and Wales) Regulations 2009:

Overhead Line Replacement - Barugh to Elmhirst Lane 66,000 Volt Line, South Yorkshire

Particulars of proposed development to be completed by Applicant:

We propose to undertake the works as shown on the enclosed plans numbered CDG1958, CDG1959 and CDG1960 that are considered to be exempted from the Electricity Act 1989 by falling within the Overhead Lines (Exemption)(England and Wales) Regulations 2009. These works involve the replacement of conductors, a new section of 66,000 Volt overhead line and a significant amount of the existing line being replaced by a design successor specification overhead line. This work will allow us to remove 17 wood house masts and 11 spans of 66,000 overhead line improving both the aesthetic of the locality and the resilience of our network.

The Council/Authority is requested to indicate that it has no objection to the work being carried out by returning two copies of this Form with the Certificate completed and signed.

Yours Faithfully



For and on behalf of the Applicant

CERTIFICATE

**TO BE COMPLETED BY THE LOCAL PLANNING AUTHORITY AND RETURNED TO
THE APPLICANT ELECTRICITY NETWORK COMPANY WITHIN SIX WEEKS OF
RECEIPT**

Barnsley Metropolitan Borough Council

(i) objects/does* not object for the proposed development detailed above to be undertaken under the exemptions laid down in the Overhead Lines (Exemption)(England and Wales) Regulations

(ii) wishes/does* not wish the Secretary of State to consider the application using the full section 37 process under the Electricity Act 1989.


The reasons for requesting the full section 37 process are*:

Signed: _____ Dated: _____
Designation: _____
on behalf of **Barnsley Metropolitan Borough Council**

**delete as appropriate*

Applicant's Reference: CDG/YC14183


SCHEME Barugh to Elmhirst Lane 66kV Line, South Yorkshire				PROJECT No. YP14183
LEGEND	VOLTAGE	EXISTING	PROPOSED	TO BE REMOVED
OVERHEAD LINE				
UNDERGROUND CABLE				
SUPPORT POSITIONS				
STAYS				
STRUTS				
SCALE 1:5000 OS PLAN No. 431098, 407811 PLAN No. CDG1958				
Based upon the Ordnance Survey map with the sanction of the controller of H.M. Stationery Office.				

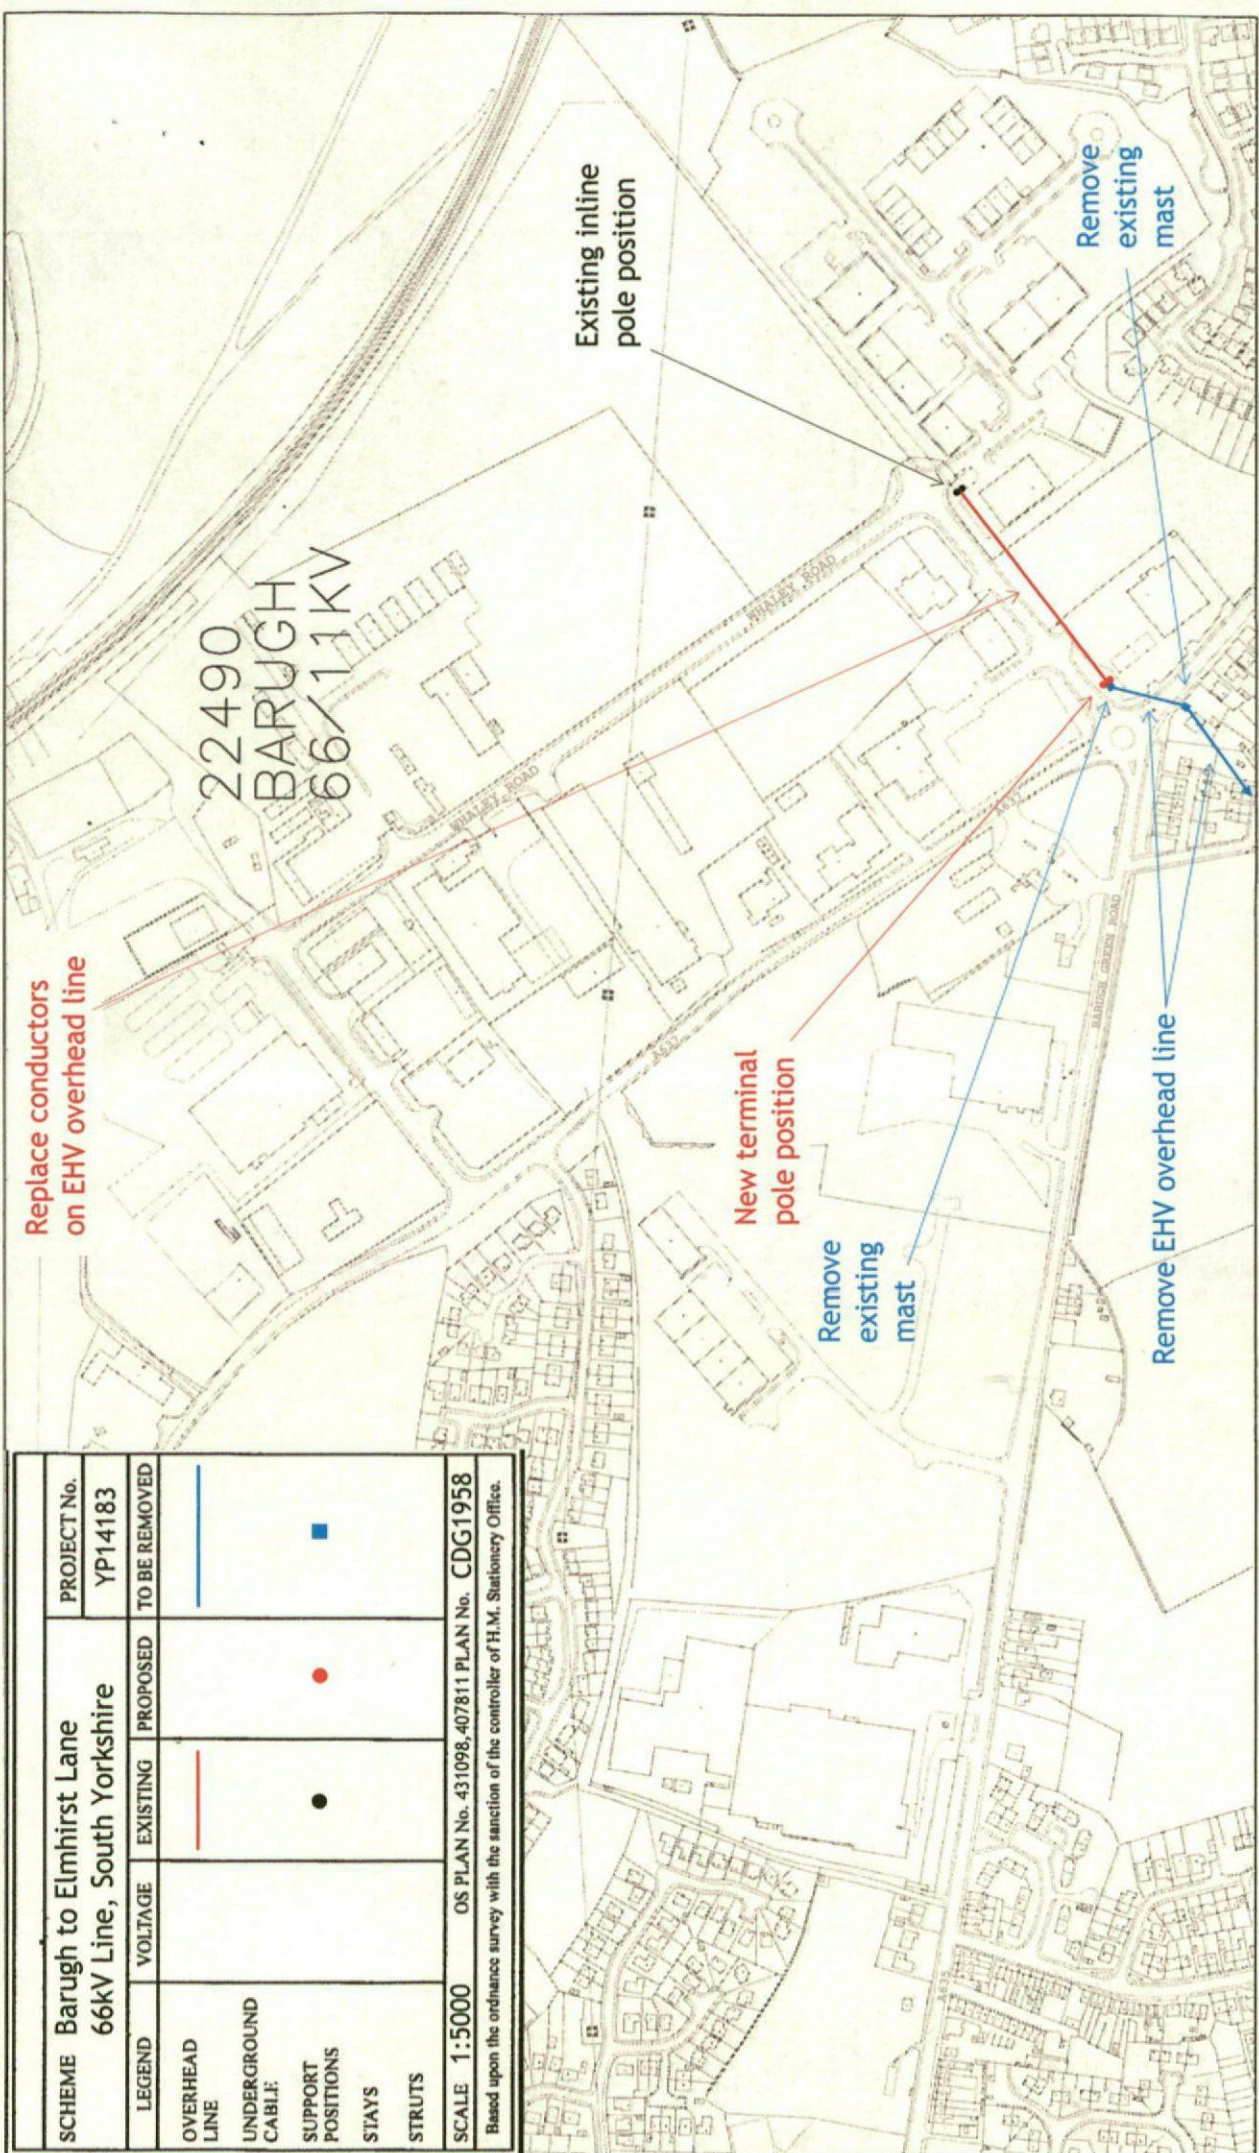

Northern Powergrid Holdings Company	Ad-hoc	14-11-2018
	431098, 407811	1:5000
		CAS2

[illegible]

CAS2

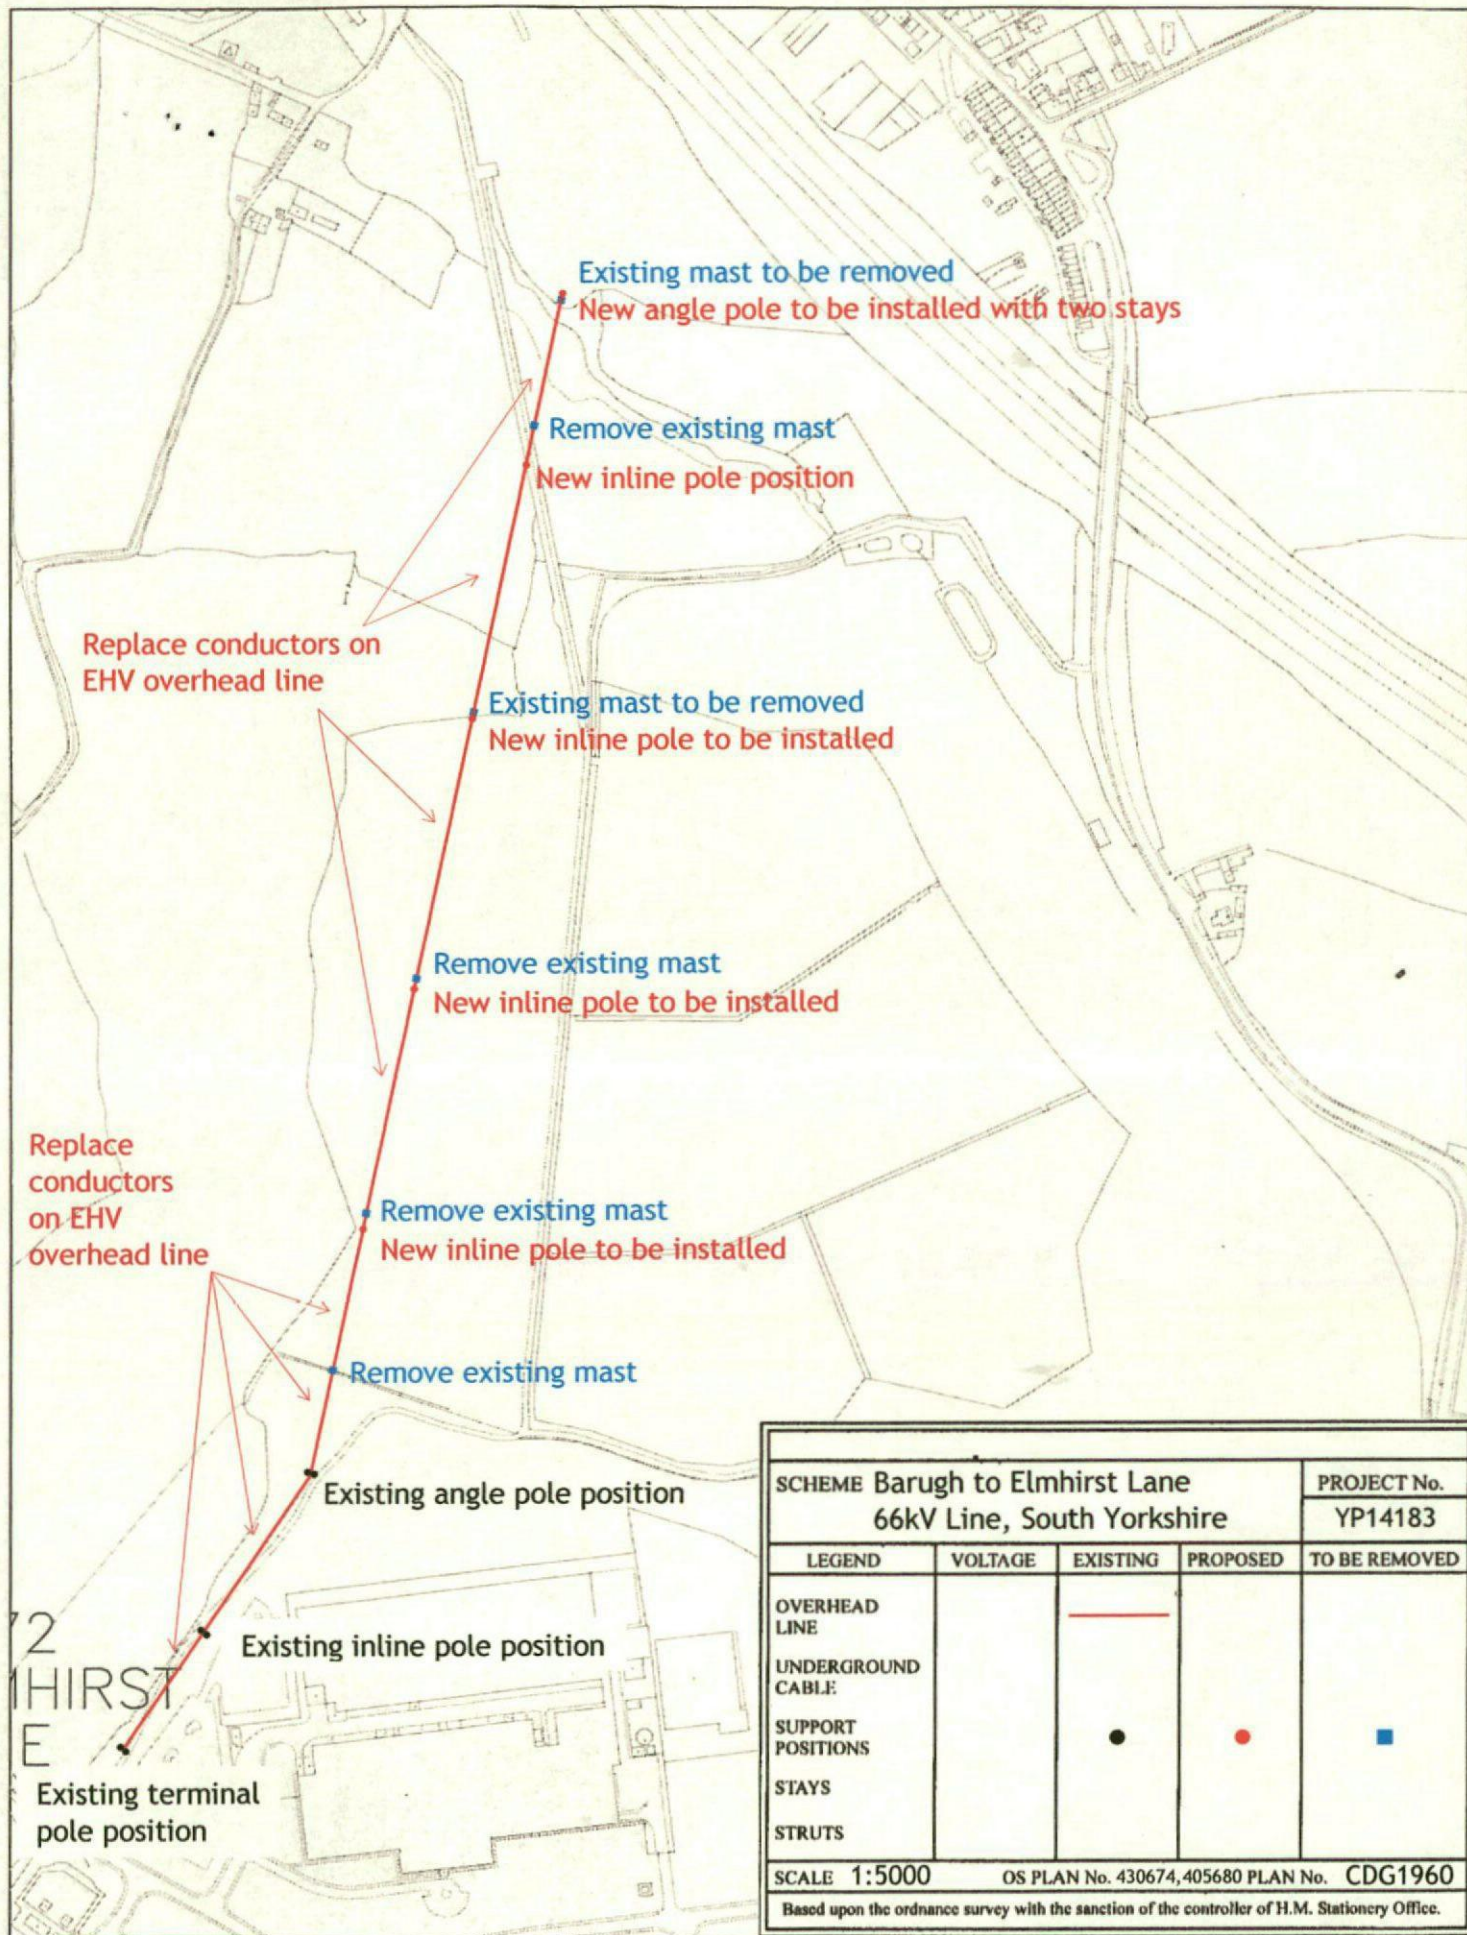

Northern
Powergrid
Holdings
Company

Ad-hoc

430674,405680

14-11-2018

1:5000

CAS2