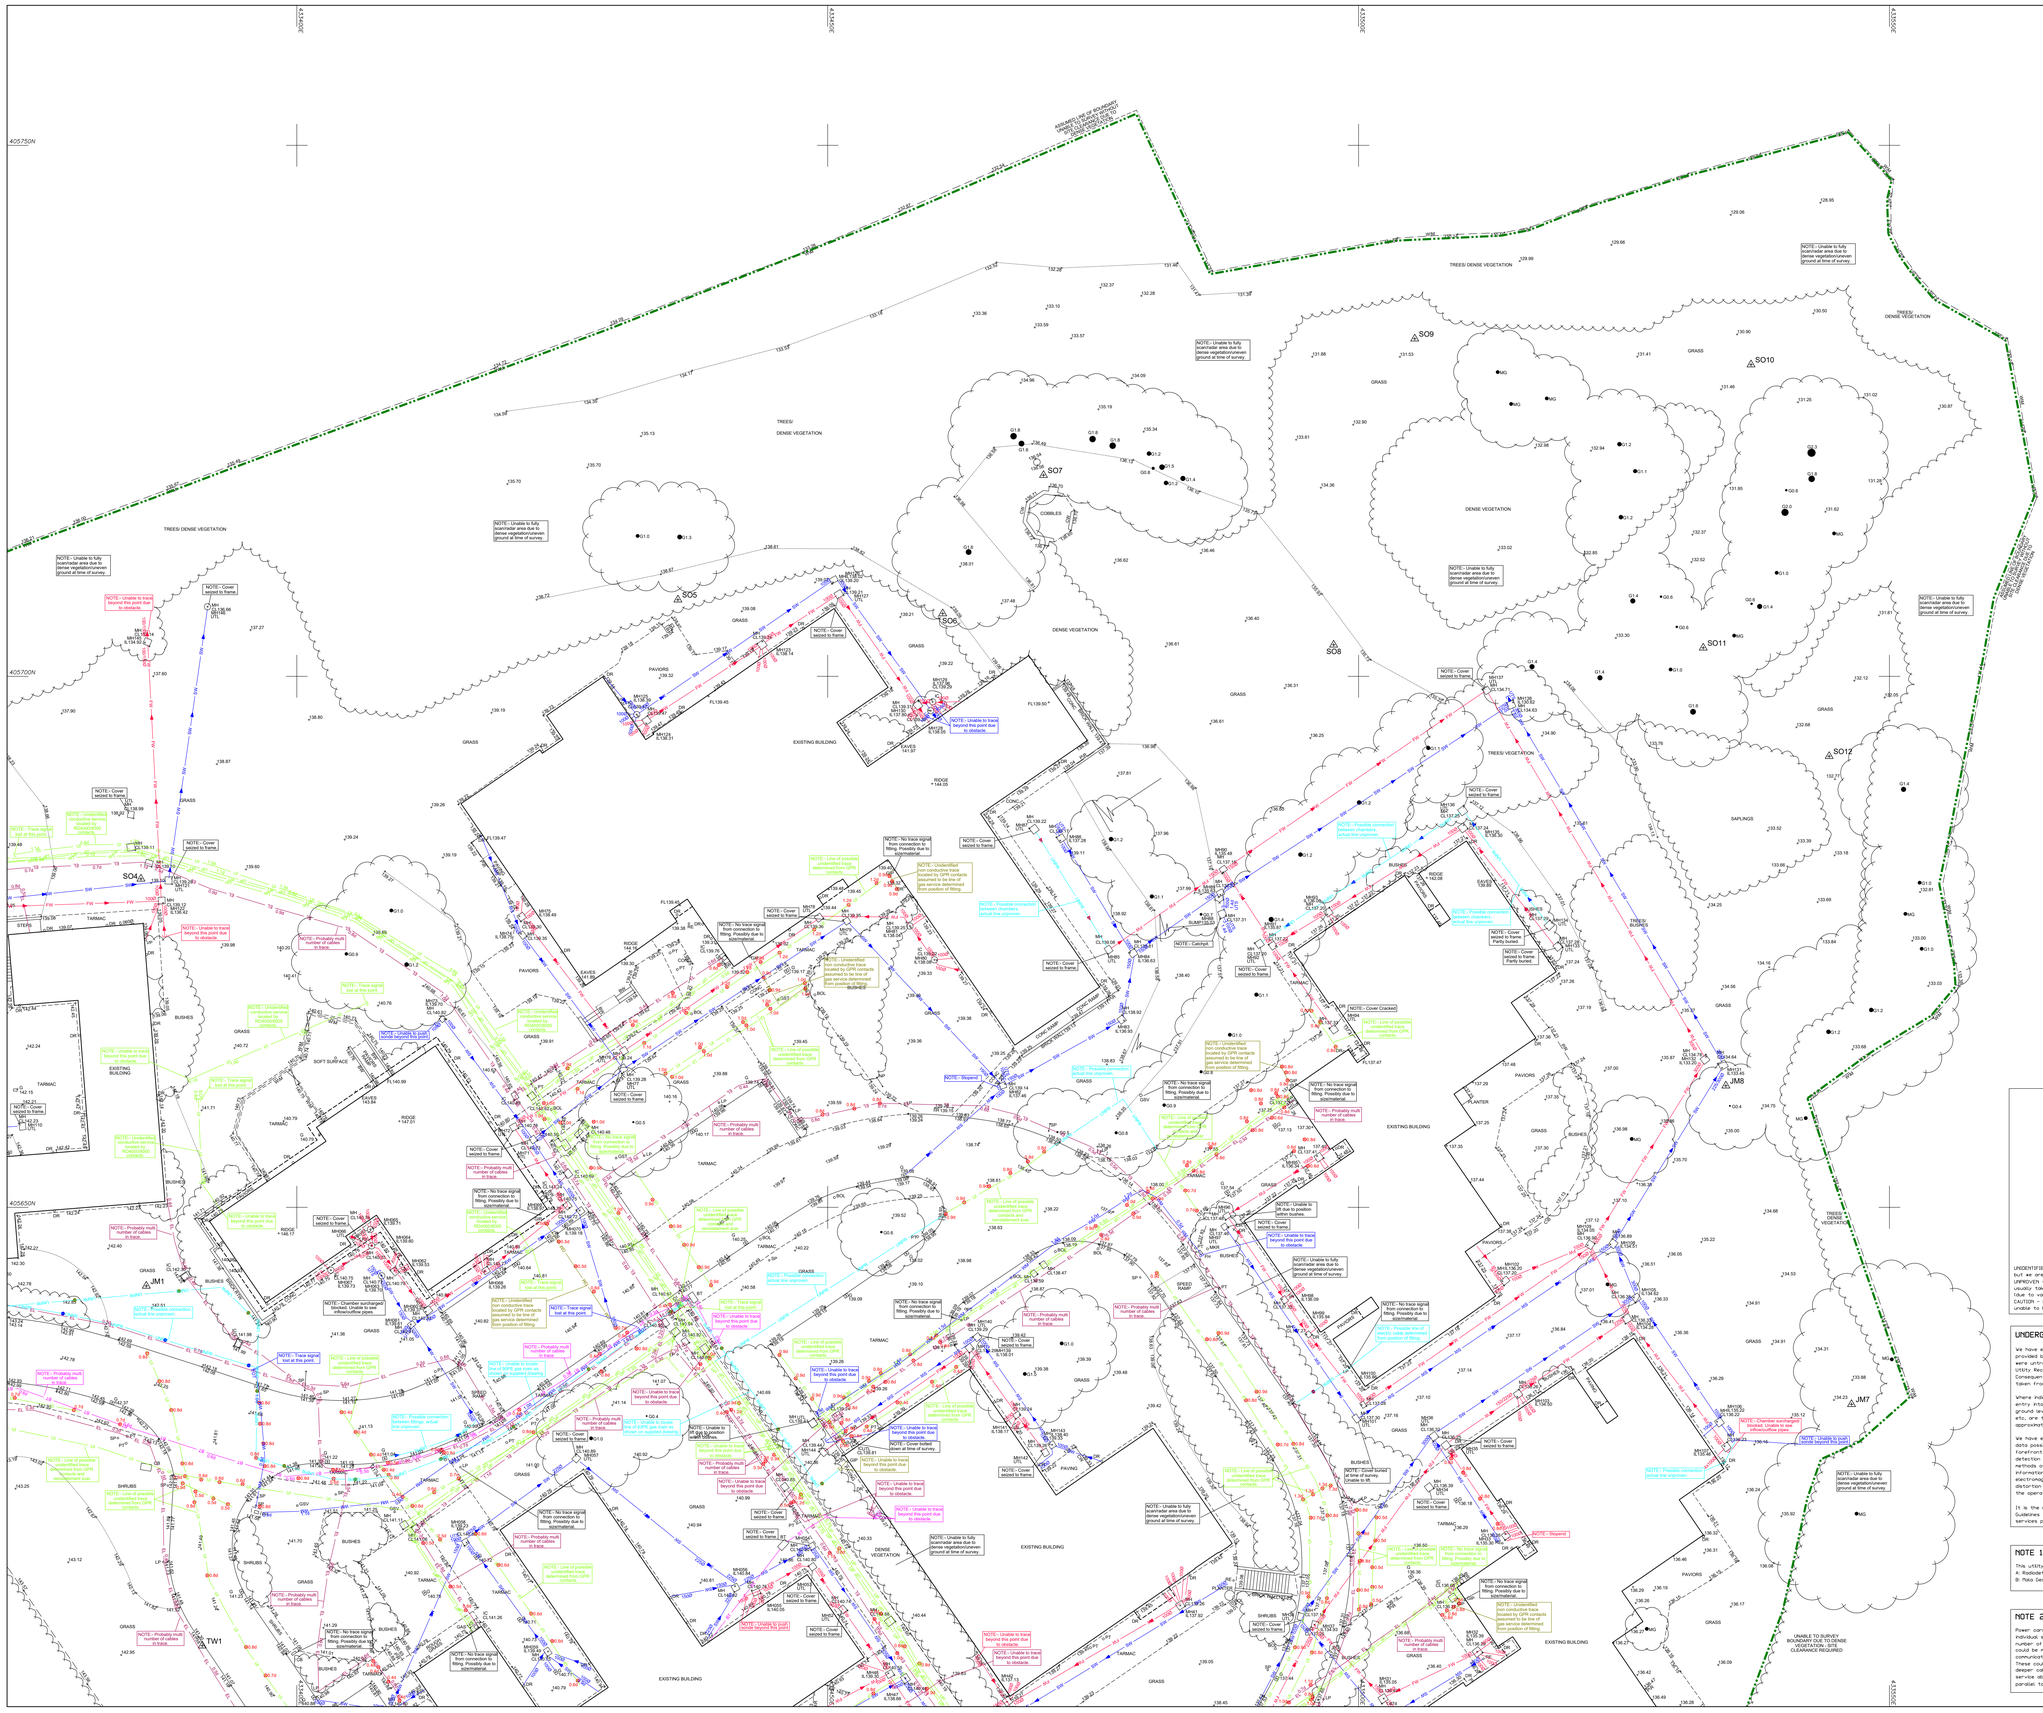

© Survey Operations Limited 2020
Reproduction in whole or in part by any means is prohibited without the prior permission of Survey Operations Limited.

N

Note:
The survey is plotted on a plane local Grid. Orientation to National Grid. All levels relate to Ordnance Datum, achieved using the OS National GPS Network.
Survey Control Markers established for Mapping purposes only and should not be used for Construction without the written approval of Survey Operations Ltd.

SURVEY STATIONS

Name	Easting	Northing	Height
SO1	433551.42	405629.27	144.06
SO2	433544.76	405688.59	139.56
SO3	433344.76	405688.58	138.56
SO4	433385.32	405680.92	139.11
SO5	433439.89	405707.21	136.99
SO6	433460.83	405705.91	139.20
SO7	433470.33	405718.83	136.66
SO8	433497.83	405702.96	136.08
SO9	433528.24	405729.15	131.53
SO10	433536.96	405729.35	131.24
SO11	433532.46	405702.68	132.87
SO12	433544.33	405692.47	132.73
TW1	433391.09	405608.72	141.35
JM1	433385.82	405649.59	142.49
JM2	433385.82	405642.59	142.49
JM3	433426.30	405578.36	140.87
JM4	433482.56	405501.79	140.24
JM5	433511.76	405546.18	137.39
JM6	433521.11	405569.80	136.45
JM7	433546.76	405631.45	135.15
JM8	433534.80	405661.45	134.85

Utility survey added to topographical survey job number 20B230_A

All drainage information must be verified with local authority records before use.

STANDARD REFERENCE & ABBREVIATIONS

(AR).....Assumed Route	IL.....Invert Level
AI.....Air Brick	IP.....Inlet Pipe
AV.....Air Valve	KO.....Kerb Outlet
B/W.....Barbed Wire	LB.....Letter Box
BAR.....Barrier	LP.....Lamp Post
BB.....Belisha Beacon	MB.....Multi-Girth
BH.....Borehole	MH.....Manhole
BL.....Bed Level	MKR.....Marker
BOL.....Bollard	MP.....Mooring Point
BS.....Bush Stop	NP.....Street Name Plate
BT Box.....British Telecom Box	O/H.....Overhead
BT.....British Telecom II	O/P.....Open Paling
BRTW.....Brick Retaining Wall	OE.....Overhead Electric Wire
BW.....Brick Wall	OP.....Outfall Pipe
C/B.....Close Boarded	ORBM.....Ordnance Survey Bench Mark
C(I).....Corrugated Iron	OT.....Overhead Telecom Wire
C/P.....Chestnut Paling	P/C.....Post & Chain
CB.....Control Box	P/R.....Post & Rail
CBW.....Concrete Block Wall	P/W.....Post & Wire
CCTV.....Closed Circuit TV	PAV.....Paving
CD.....Cable Duct	PB.....Pillar Box
CEL.....Cellar Light	PC.....Pedestrian Crossing
CHL.....Chain Link	PF.....Petrol Pump
CHM.....Chimney	PT.....Post or Pillar
CL.....Cover Level	RE.....Reading Eye
CB.....Cable Marker	RS.....Road Sign
COL.....Column	RTW.....Retaining Wall
CONC.....Concrete	RWP.....Rain Water Pipe
CP.....Catch Pit	SAP.....Sapling
CRTW.....Concrete Retaining Wall	SL.....Sump Level
CTV.....Cable Television	SWL.....Soffit Level
CUL.....Culvert	SP.....Sign Post
CW.....Concrete Block Wall	SPL.....Springing Level
DC.....Drainage Channel	SRTW.....Stone Retaining Wall
DPC.....Damp Proof Course	SV.....Stop Valve (unspecified)
DR.....Drain	SVP.....Soil Vent Pipe
DSW.....Dry Stone Wall	SW.....Stone Wall
EGP.....Electricity Cable Pit	TAR.....Tarmac Paving
ESC.....Electricity Inspection Cover	TB.....Traffic Bollard
Ex.....Expansion Joint	TBM.....Temporary Bench Mark
EJB.....Electricity Junction Box	TCB.....Telephone Call Box
EL SUB STN..Electricity Sub Station	TFR.....Taken From Records
EL.....Eaves Level	TIE.....Anchor Point (Mast/Pylon)
ELB.....Electricity Box	TL.....Traffic Light
EP.....Electricity Pole	TLB.....Traffic Light Control Box
ER.....Earth Rod	TR.....Timber Rockery
ETL.....Electricity Transmission Line	TWC.....Tarmac
FB.....Flower Bed	TY.....Telecommunications Pole
FH.....Fire Hydrant	TP(T).....Trial Pit
FL.....Floor Level	TS.....Trash Screen
FP.....Flag Pole	U/C.....Under Construction
G(*.*).....Girth (of tree)	U/G.....Underground
G.....Gulley	UTL.....Unable To Lift (BM,SI etc)
GAB.....Gabion	UTS.....Unable To Survey
GIP.....Gas Inlet Pipe	VDP.....Vehicle Detector Pad
GMKR.....Gas Marker	VT.....Vent Pipe
GST.....Gas Stop Tap (Domestic)	W/B.....Wire Mesh
GSV.....Gas Stop Valve (Mains)	WL.....Water Level
HSG.....Housing	WM.....Water Meter
HT.....Height	WO.....Wash Out
HV.....High Voltage	WP.....Waste Pipe
I/R.....Iron Railing	WST.....Water Stop Tap (domestic)
IC.....Inspection Cover	WSV.....Water Stop Valve (mains)

SW	STORM WATER SEWERS
FW	FOUL WATER SEWERS
WM	WATER MAIN
GM	GAS MAIN
EL	ELECTRIC CABLES
DUCT	CABLE DUCTING
BT	BT (UNDERGROUND)
CCTV	CABLE TV
CCTV	CLOSED CIRCUIT TV
UF	UNIDENTIFIED FEATURE
UP	UNIDENTIFIED PIPE
UC	UNIDENTIFIED CABLE
UNPRO	UNPROVEN FEATURE
SW C	END OF TRACE
FW C	LATERAL CONNECTIONS
	EXTENT OF SURVEY BY SURVEY OPERATIONS LTD.
	EXTENT OF SURVEY BY OTHERS (SEE REPORT)
0.0m	BURIED FEATURE FOUND USING RADAR
FW SW	CONNECTIVITY BETWEEN CHAMBERS FROM CCTV REPORT
	BURIED FEATURE FOUND USING RADAR

UNIDENTIFIED - A buried feature or utility that has been located, but we are unable to state what it is.
UNPROVEN - The assumed location of a reported feature or utility, usually taken from records, but not found during the utility trace (due to various conditions).
CAUTION - Electric put ended cables, even when they are live, are unable to be detected or traced.

UNDERGROUND UTILITIES SERVICES DISCLAIMER

We have endeavoured to locate existing services using records provided by Statutory Authorities as a guide. Some apparatus were unknowns and details have therefore been taken from Utility Record Drawings, which may be of poor quality. Consequently we cannot guarantee accuracy of information taken from such records.

Where indicated, no allowance has been made for sub-surface entry into manholes, other chambers or confined spaces below ground level. Therefore any details relating to depths, sizes etc, are taken from the surface and as such MA be approximate.

We have endeavoured to supply you with the most accurate data possible by using methods and equipment that are at the forefront of our industry. We have taken great care in the detection of pipework and buried features, but as with all methods of detecting underground or buried utilities the information provided is based on results obtained from electromagnetic techniques, and as such may be liable to distortion or errors beyond the reasonable control of the operator or his instruments.

It is the responsibility of the user under Health & Safety (HSG47) Guidelines to satisfy himself of the suspected location of any services prior to excavation of the services shown.

NOTE 1

This utility survey has been undertaken using:
A Radiodetection RD4000 + RD400 TX2
& Mala Geoscience Ground Probing Radar

NOTE 2

Power carrying features shown on this drawing are shown as an individual service line. This does not necessarily represent the number of cables actually present and it is possible that there could be multi numbers of cables including HV, LV and communications transmission cables following the same trace line. These could be at different depths, the trace signal from the deeper cables being masked by signal emitted from the shallower service above. Cable runs could also be present running parallel to the single line shown.

1	2
3	4
5	

SurveY OPERATIONS
Smith Street, Skelmersdale, Lancs. WN8 8LN
Tel: 01695 725662 Fax: 01695 51816
Email: mail@survops.co.uk – www.survops.co.uk

Client
Waterman Infrastructure & Environment

Drawing Title
Utility Survey of Land at:
Trinity Academy
Barnsley
Sheet 2 of 5

Scale(s)	1:200	Surveyor	MB/TW
Date	Jul 20	Drawn	IT
Job Number	20F040	Checked	TW/MB/IT

Sheet Size & Drg Number & Revision
A0 20F040/002