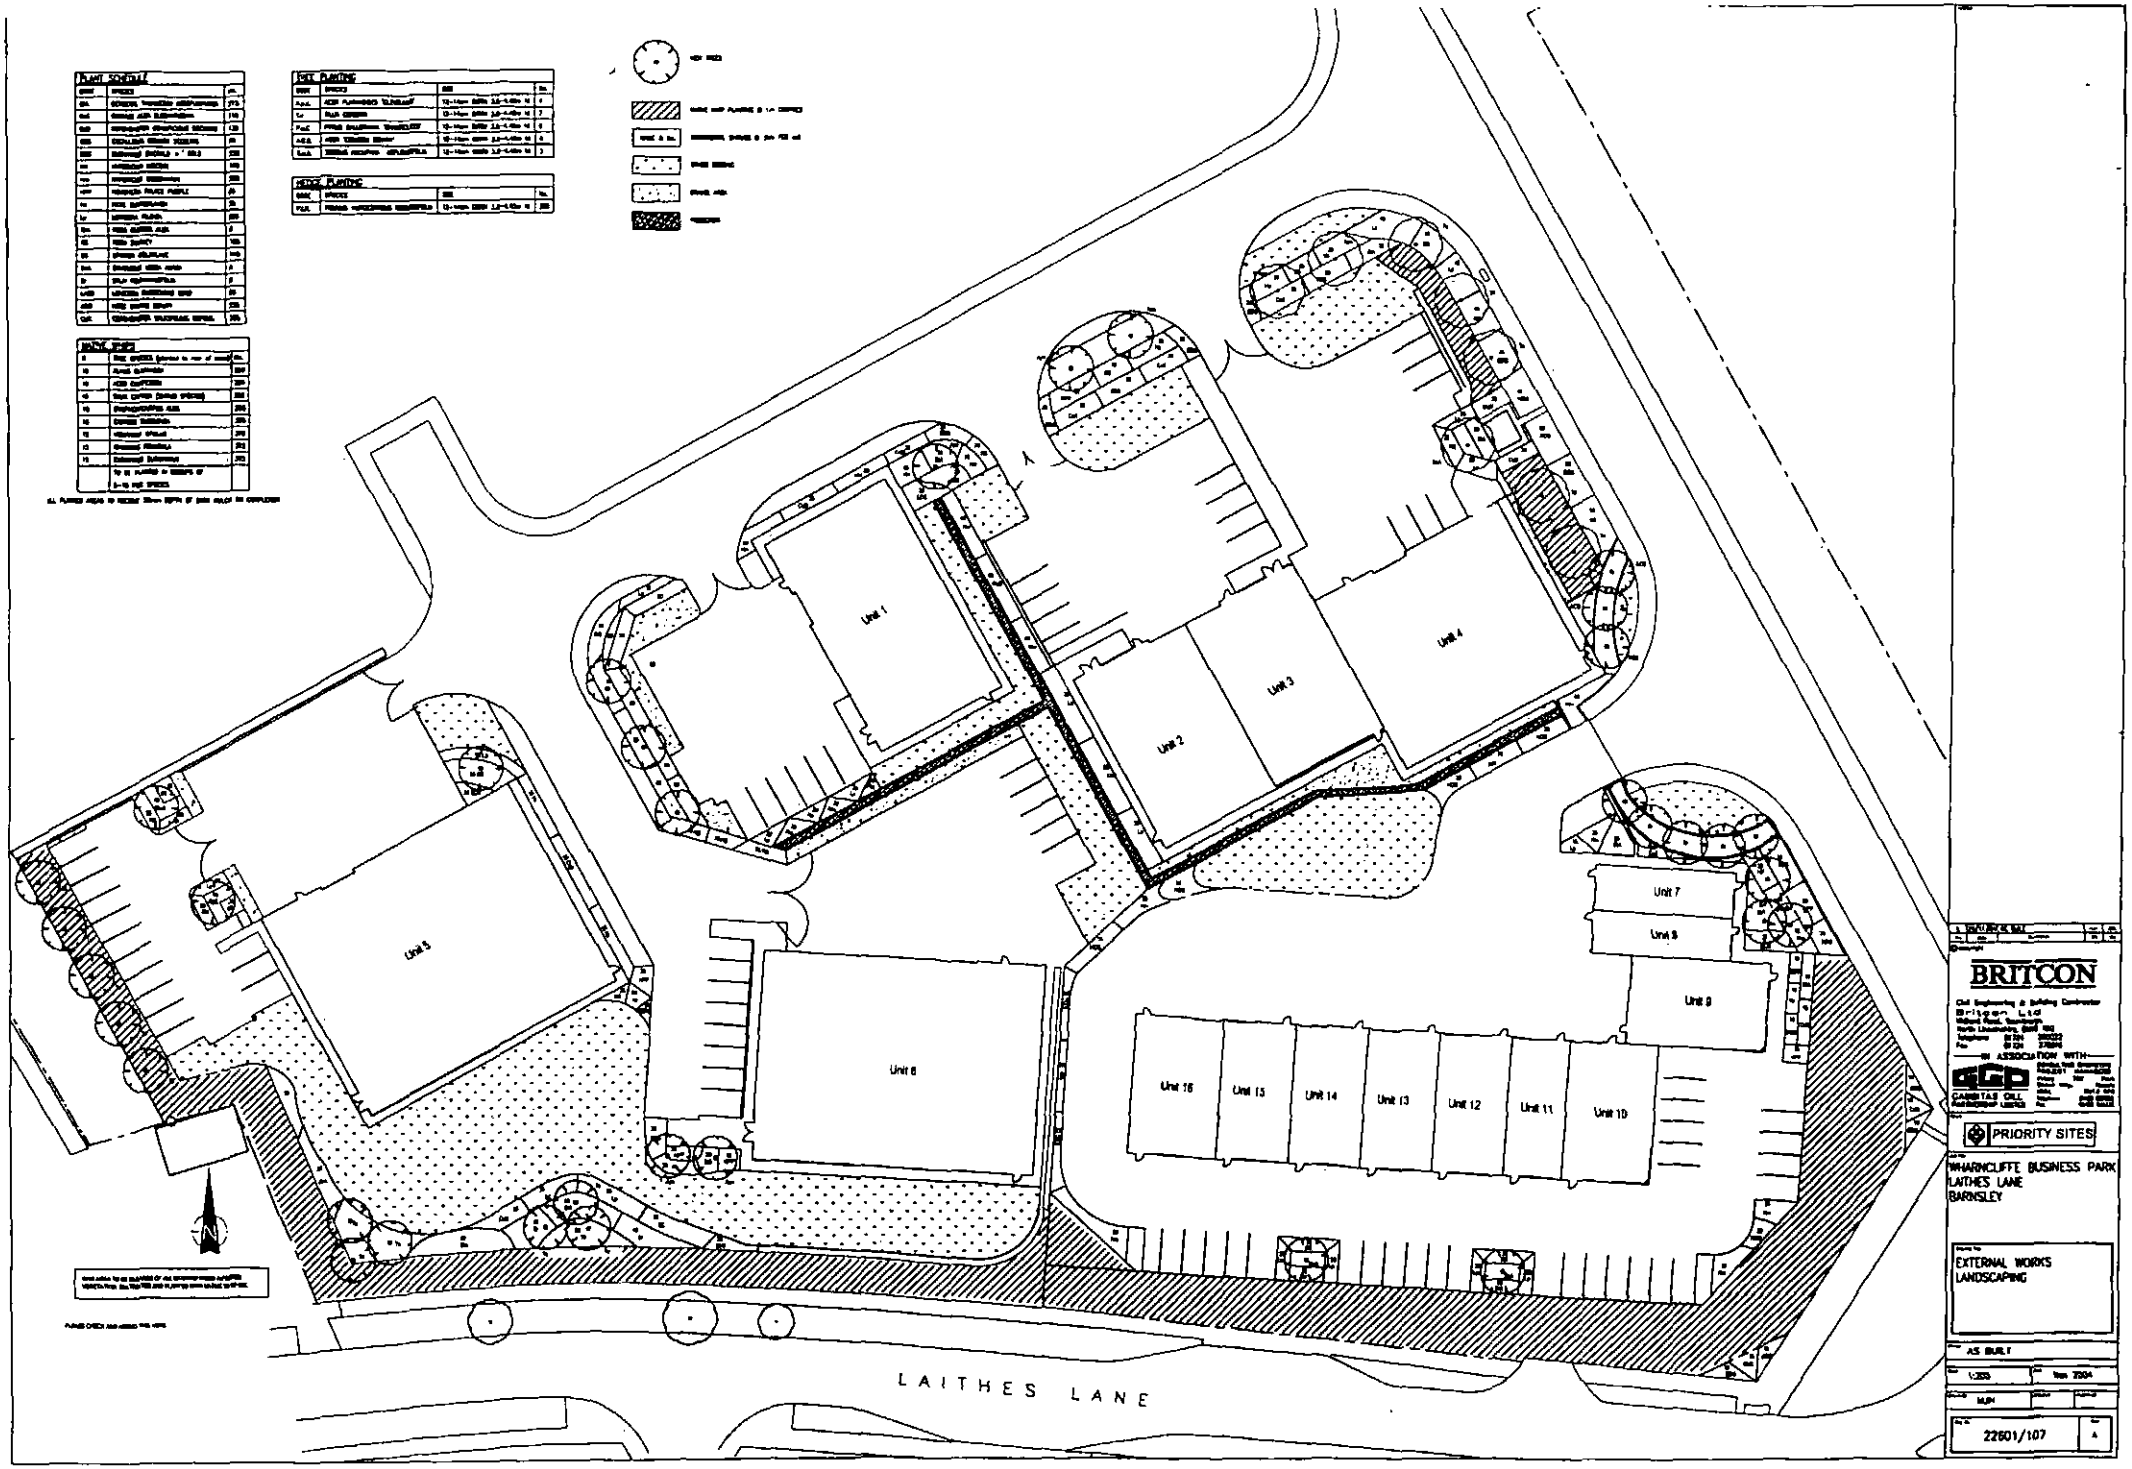

Unit 1
Unit 2
Unit 3
Unit 4
Unit 5
Unit 6
Unit 7
Unit 8
Unit 9
Unit 10
Unit 11
Unit 12
Unit 13
Unit 14
Unit 15
Unit 16
LAITHES LANE
BRITCON
PRIORITY SITES
WHARNCLIFFE BUSINESS PARK
LAITHES LANE
BARNSLEY
EXTERNAL WORKS
LANDSCAPING
AS BUILT
22601/107