

PROPOSED WORK SHOWN IN RED

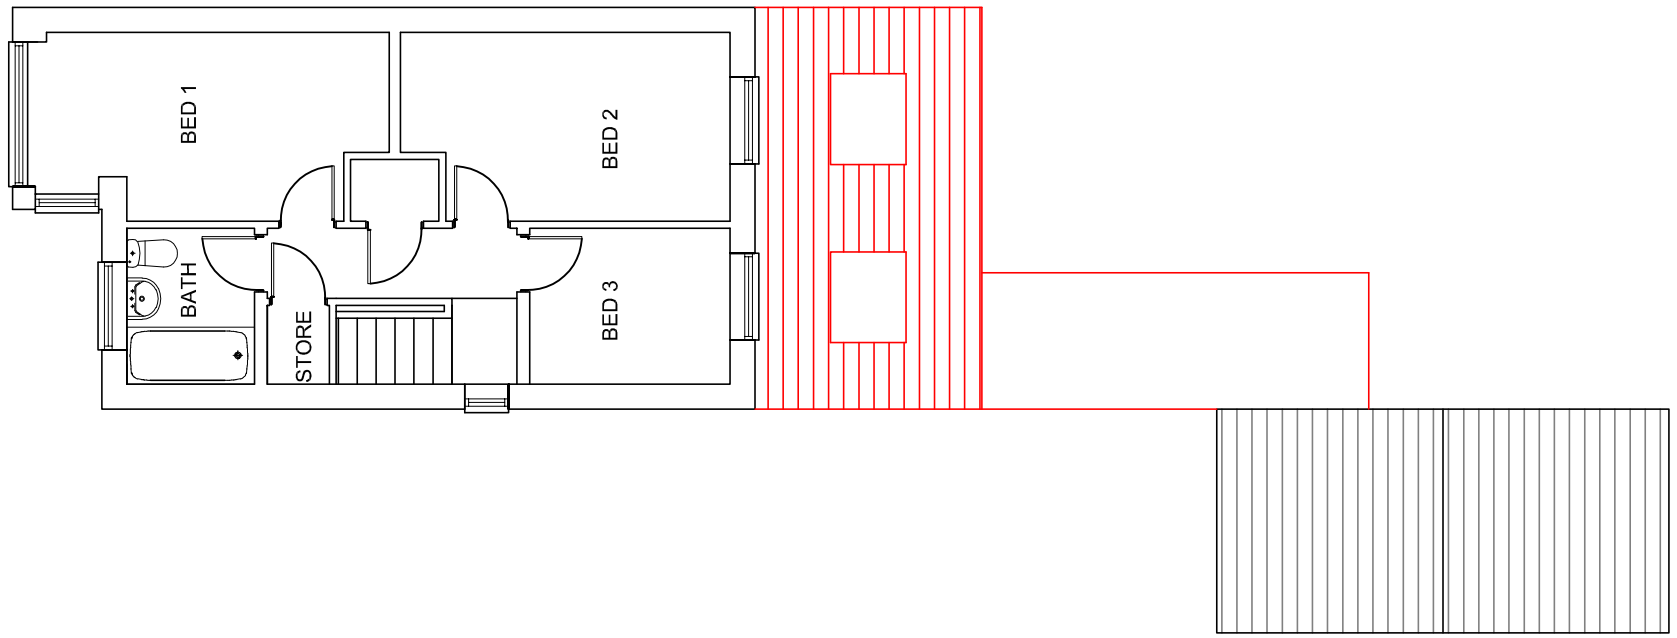

first floor

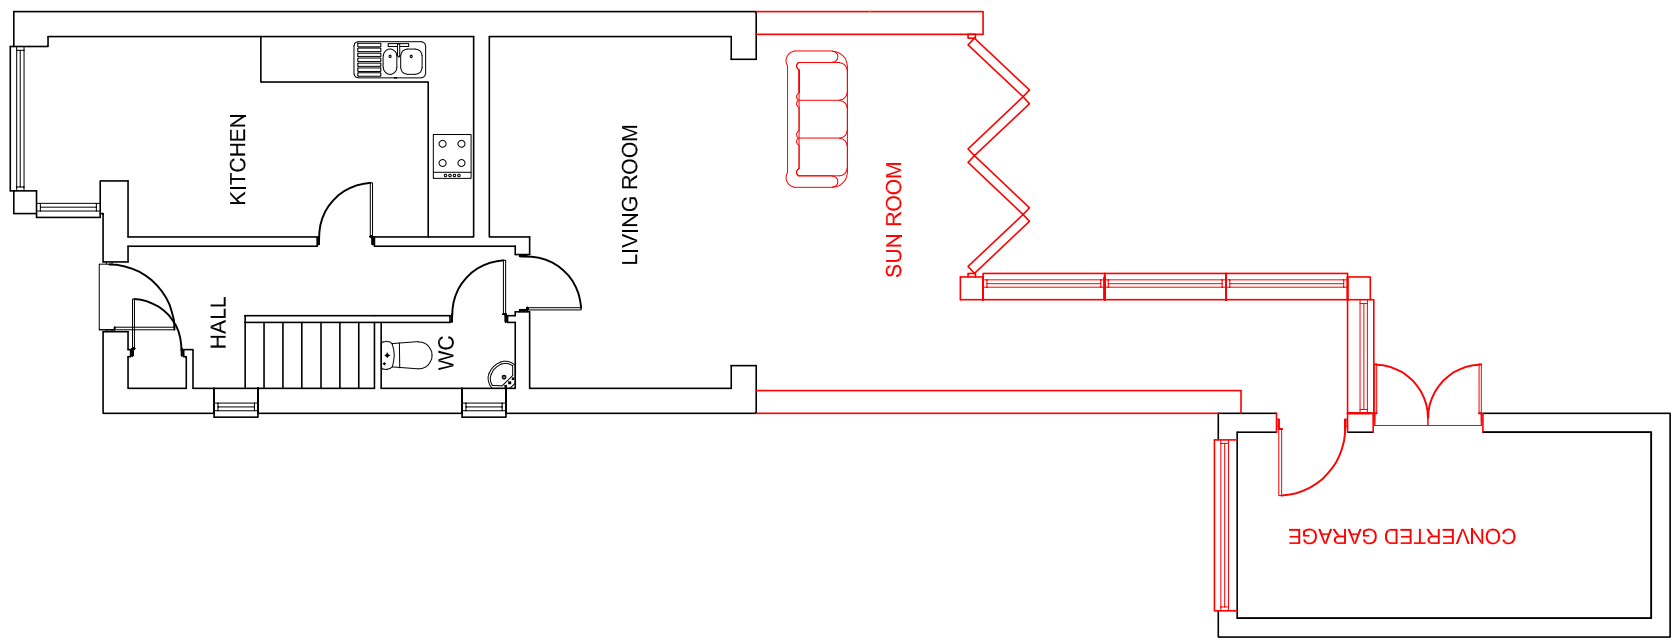

ground floor

Address: 1 Grosvenor Gardens, Barnsley, S70 6JH	O.S.Ref: SE2829ne	Date: Sept' 17	PROPOSED PLANS
Scale: 1:100 at A3	Drawn By: AH	Plan No: AH0131-5c	