
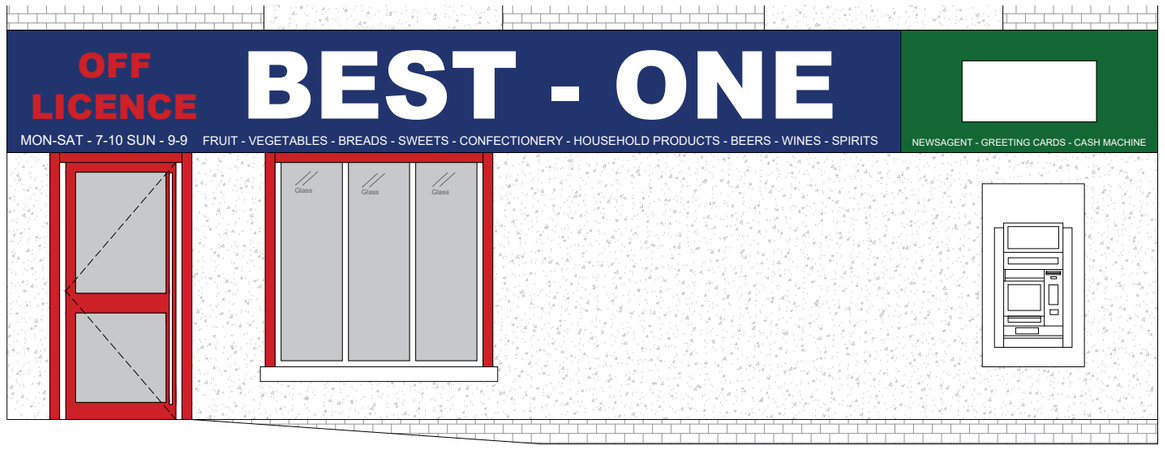



PRE-EXISTING FRONT ELEVATION

Scale 1:50

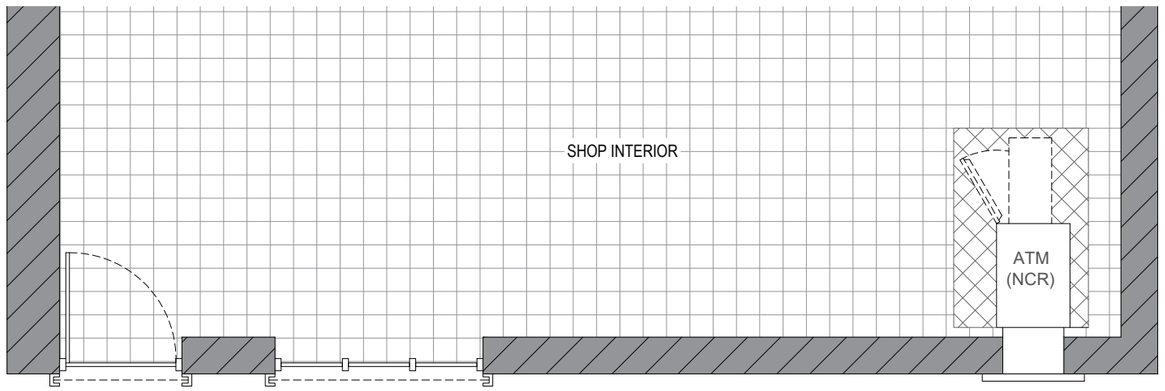

PRE-EXISTING PART PLAN

Scale 1:50

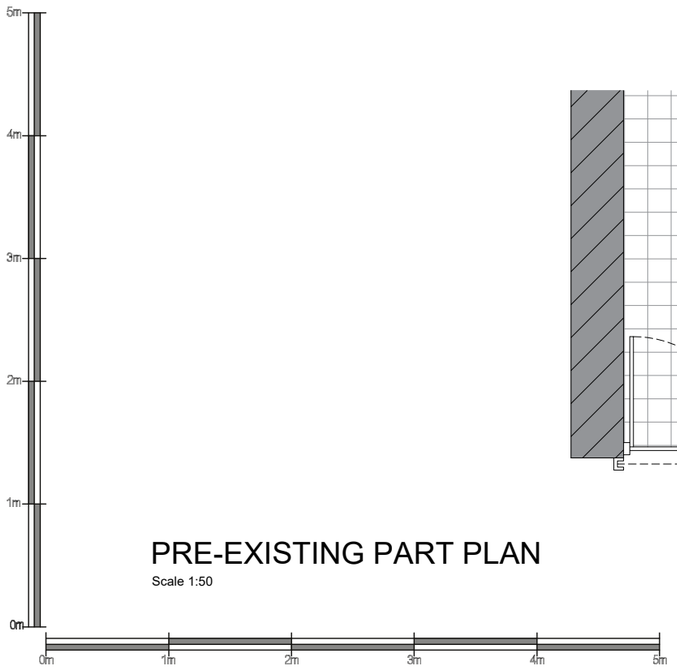

NM GROUP

Date:	Comments:	By:

GENERAL NOTES:

1) All dimensions in millimeters unless otherwise stated.

Site:
Best One,
343-345 Pontefract Road,
Barnsley,
S71 5HS

Drawing Title:

As-Installed Plan and Elevation

Ref:	Date:	Rev:
T019293_PE	23/08/2019	
Scale: 1:50	Paper: A3	Date Rev: