
Please not the only alteration is removal of the counter in image (2).


(1)

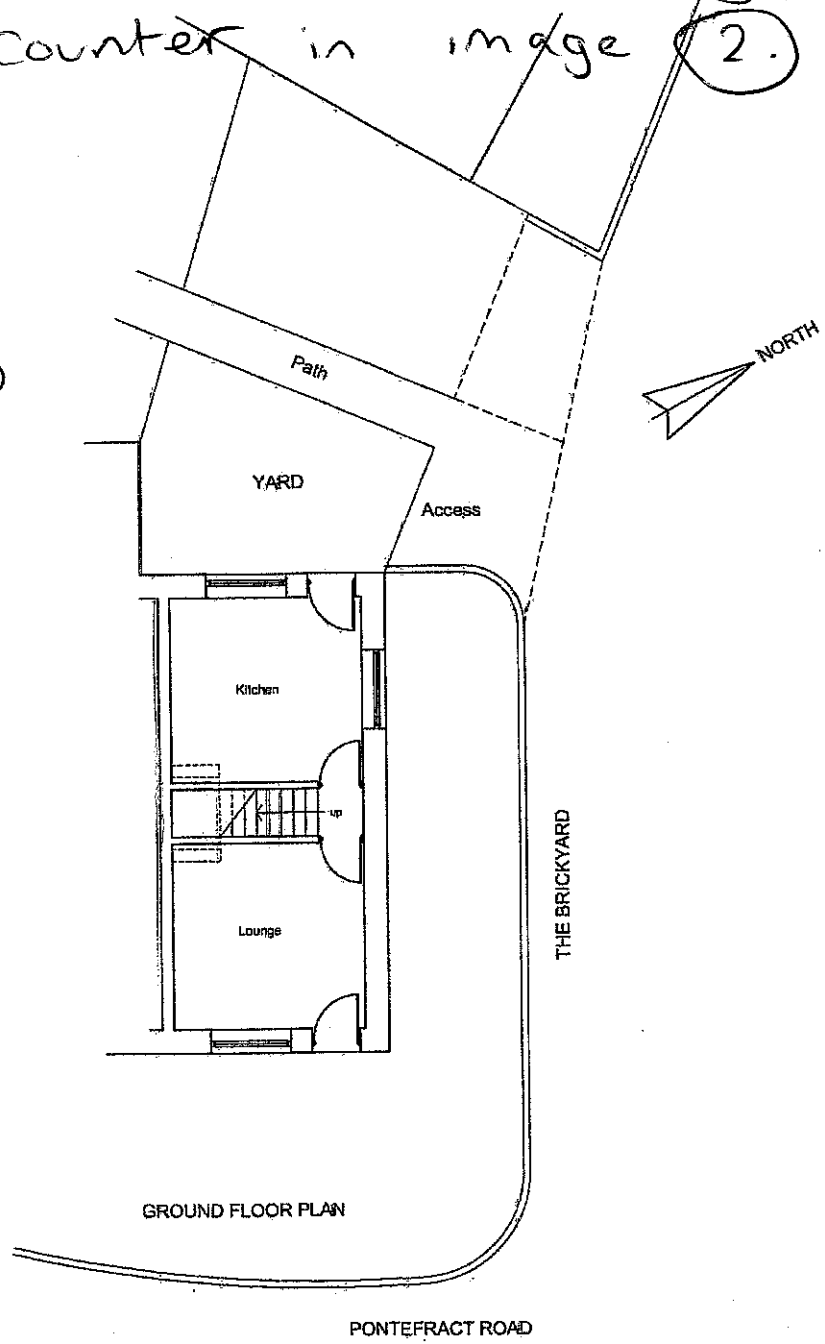

~~AS EXISTING~~

• PROPOSED

(2)

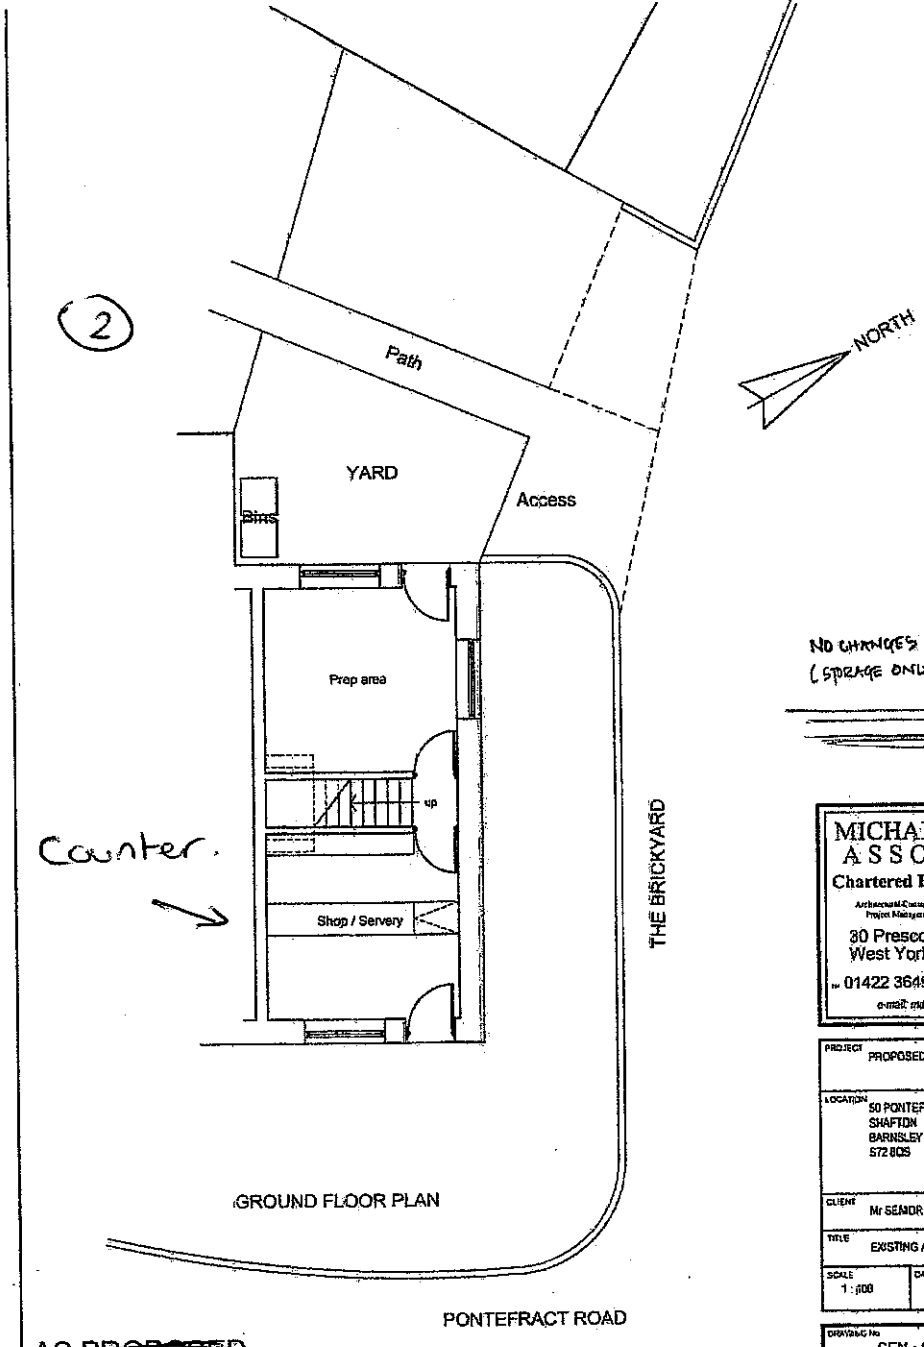


~~AS PROPOSED~~

• EXISTING.

NO CHANGES AT FIRST FLOOR (STORAGE ONLY).

MICHAEL DENTON ASSOCIATES
Chartered Building Surveyors
Architectural Consultants, Civil & Structural Engineers
Project Managers & Town Planning Consultants
30 Prescott Street, Halifax
West Yorkshire, HX1 2LG
tel 01422 364983 fax 01422 369212
e-mail: mda@md-associates.co.uk


PROJECT	PROPOSED CHANGE OF USE
LOCATION	50 PONTEFRACT ROAD SHAFTON BARNSLEY S72 8QS
CLIENT	Mr SEAMOR
TITLE	EXISTING AND PROPOSED
SCALE	1 : 100
DATE	NOV 2011
DRAWN	RH
DRAWING No	SEN : 01
Revision	

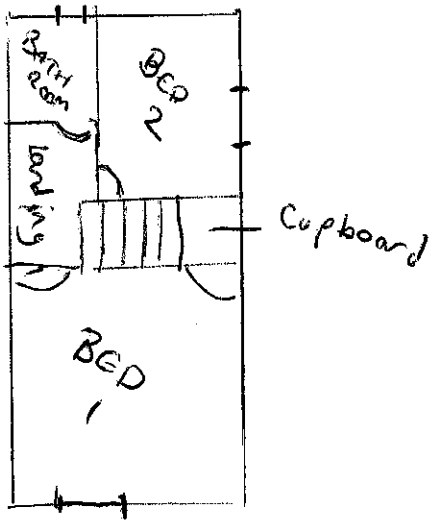

First Floor.

Please note upstairs was never altered.

H.M. LAND REGISTRY		TITLE NUMBER	
		SYK 411538	
ORDNANCE SURVEY PLAN REFERENCE	SE 3910	SECTION J	Scale 1/1250
COUNTY SOUTH YORKSHIRE	DISTRICT BARNSLEY		© Crown copyright 1998

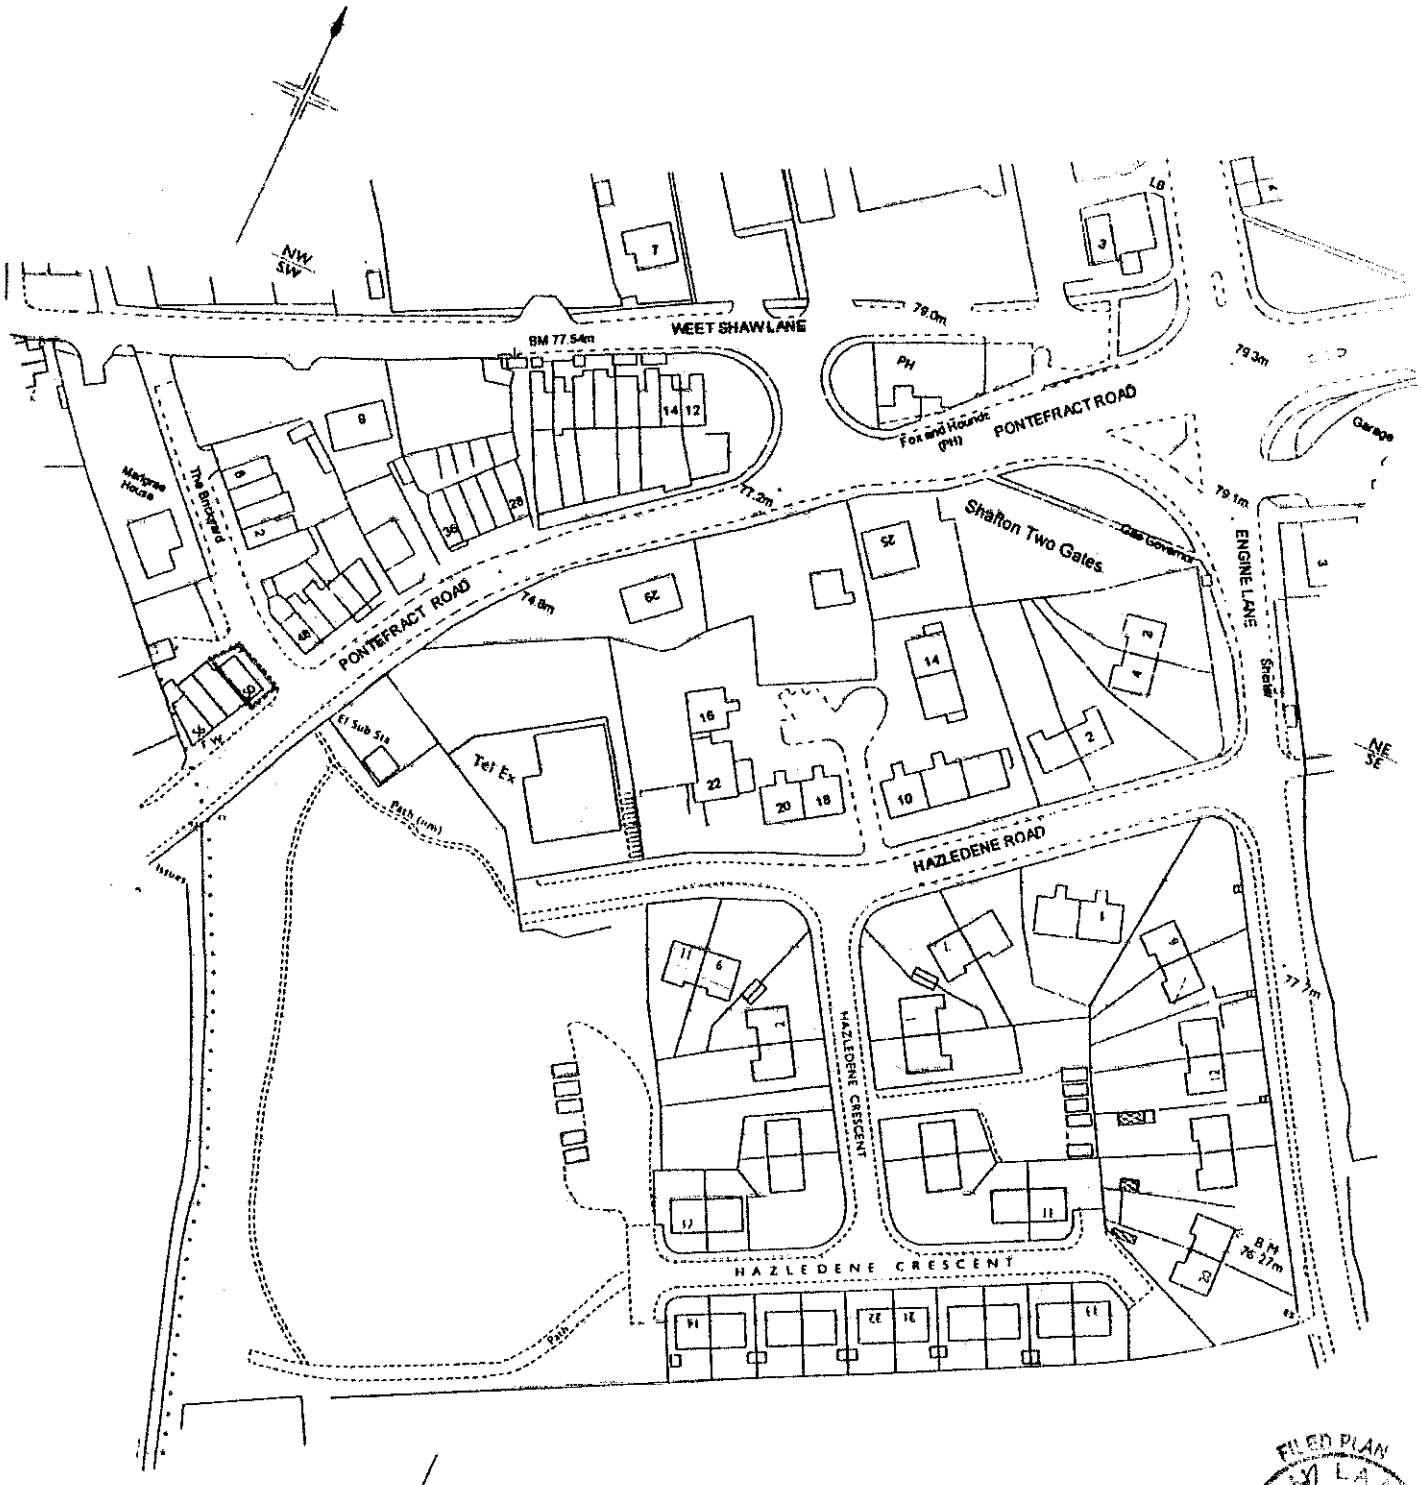

FILED PLAN
30/9/98

This official copy is incomplete without the preceding notes page.

These are the notes referred to on the following official copy

The electronic official copy of the title plan follows this message.

Please note that this is the only official copy we will issue. We will not issue a paper official copy.

This official copy was delivered electronically and when printed will not be to scale. You can obtain a paper official copy by ordering one from HM Land Registry.

This official copy is issued on 23 October 2023 shows the state of this title plan on 23 October 2023 at 16:36:18. It is admissible in evidence to the same extent as the original (s.67 Land Registration Act 2002). This title plan shows the general position, not the exact line, of the boundaries. It may be subject to distortions in scale. Measurements scaled from this plan may not match measurements between the same points on the ground.
This title is dealt with by the HM Land Registry, Nottingham Office .

© Crown copyright. Produced by HM Land Registry. Reproduction in whole or in part is prohibited without the prior written permission of Ordnance Survey. Licence Number 100026316.