
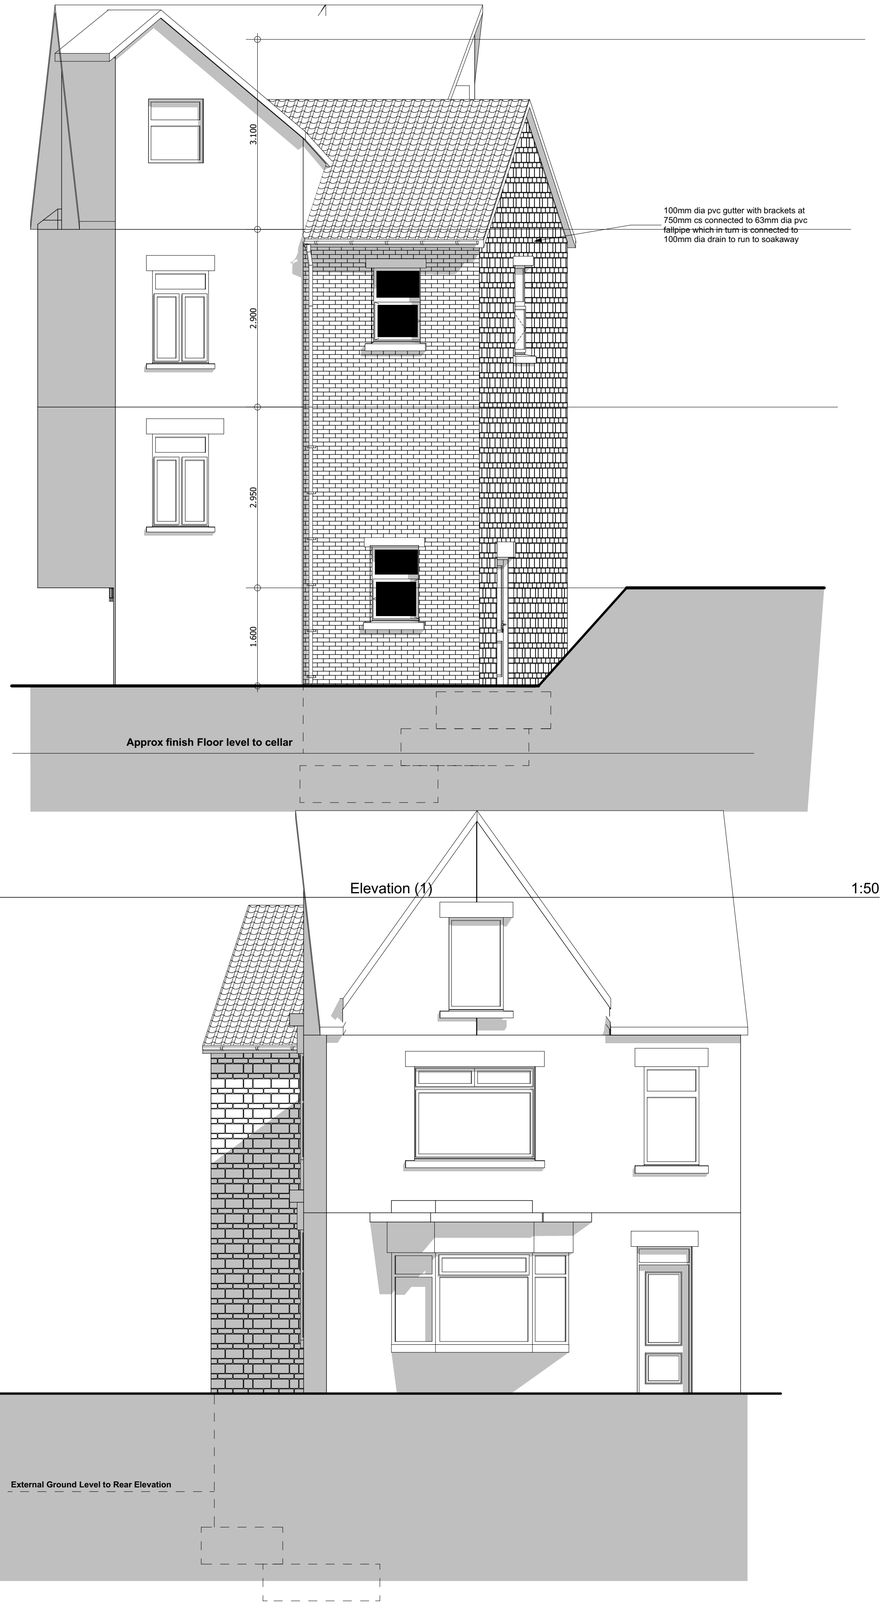


A-16 Elevation (1) 1:50

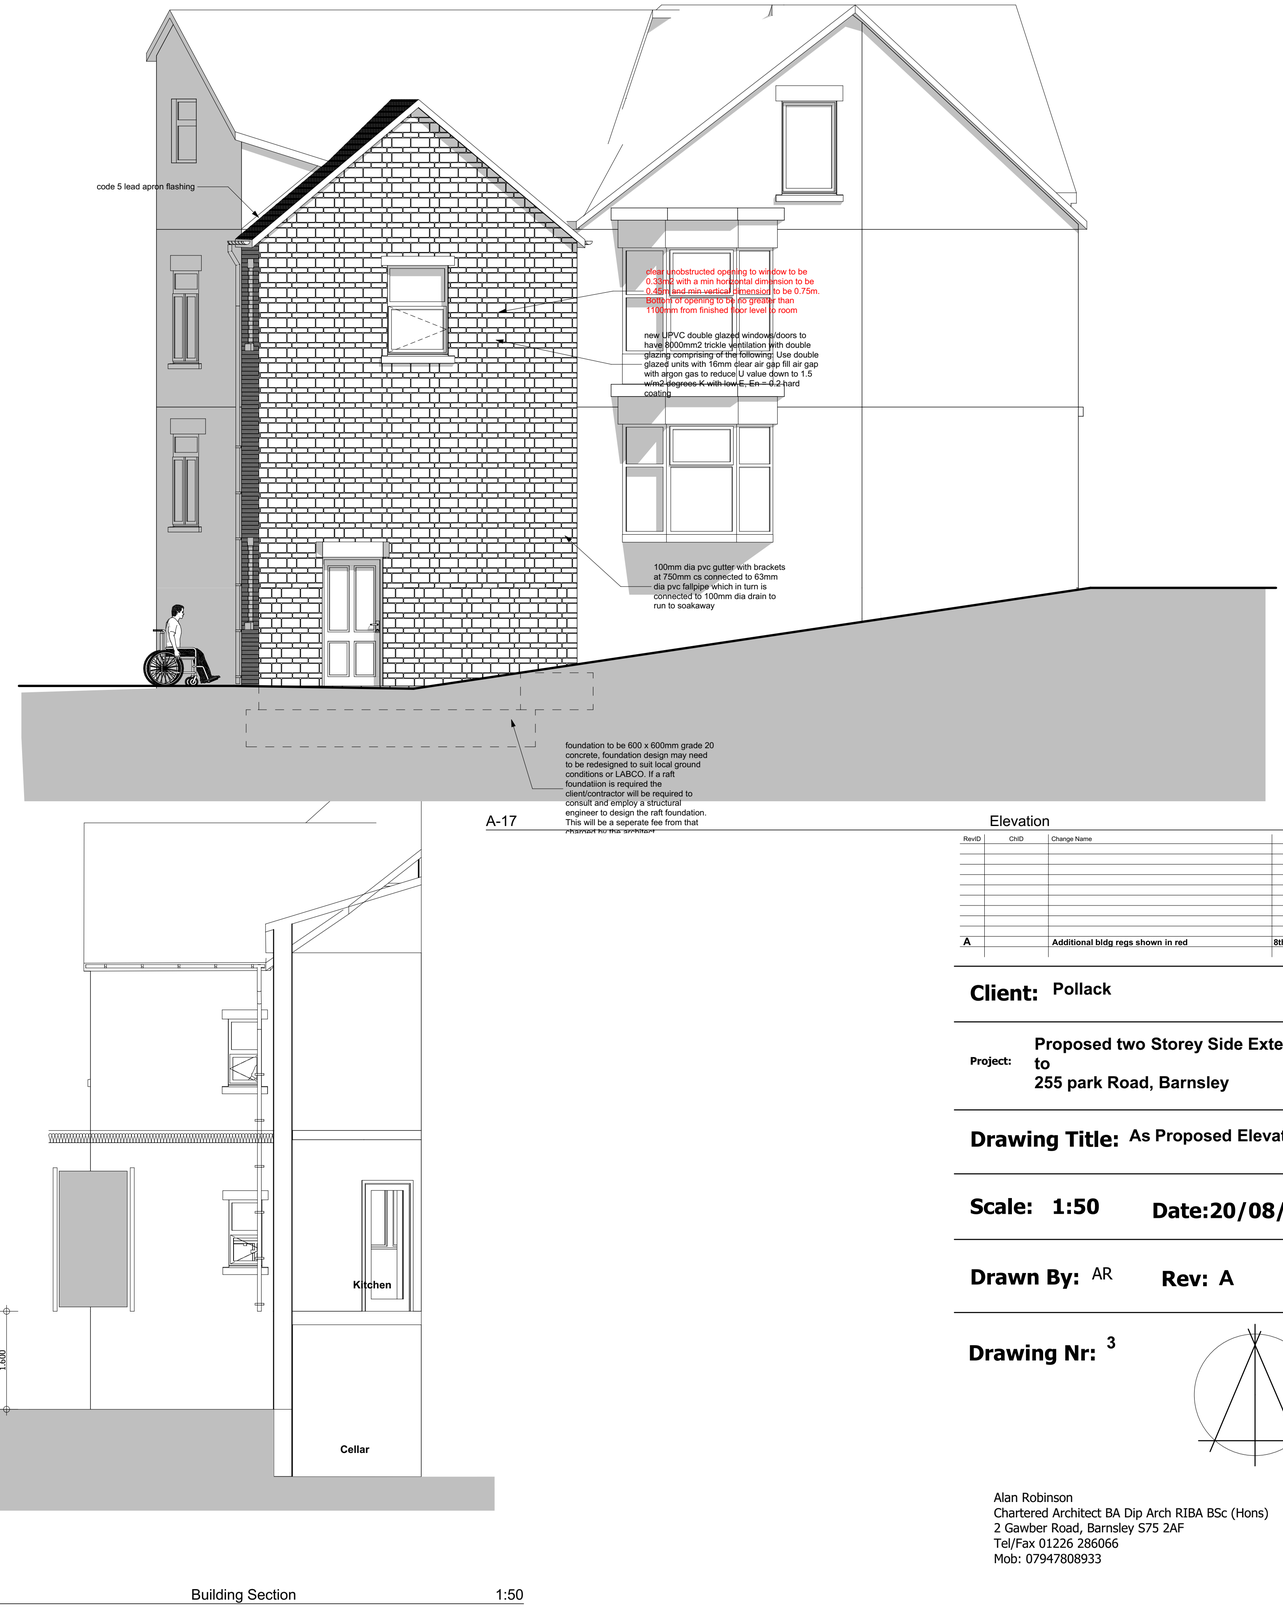

A-17 Elevation

S-54 Building Section 1:50

A-18 Elevation 1:50

RevID	ChID	Change Name	Date
A		Additional bldg regs shown in red	8th May 2020

Client: Pollack

Project: Proposed two Storey Side Extension to
255 park Road, Barnsley

Drawing Title: As Proposed Elevations

Scale: 1:50 **Date:**20/08/2020

Drawn By: AR **Rev:** A

Drawing Nr: 3

Alan Robinson
Chartered Architect BA Dip Arch RIBA BSc (Hons)
2 Gawber Road, Barnsley S75 2AF
Tel/Fax 01226 286066
Mob: 07947808933