
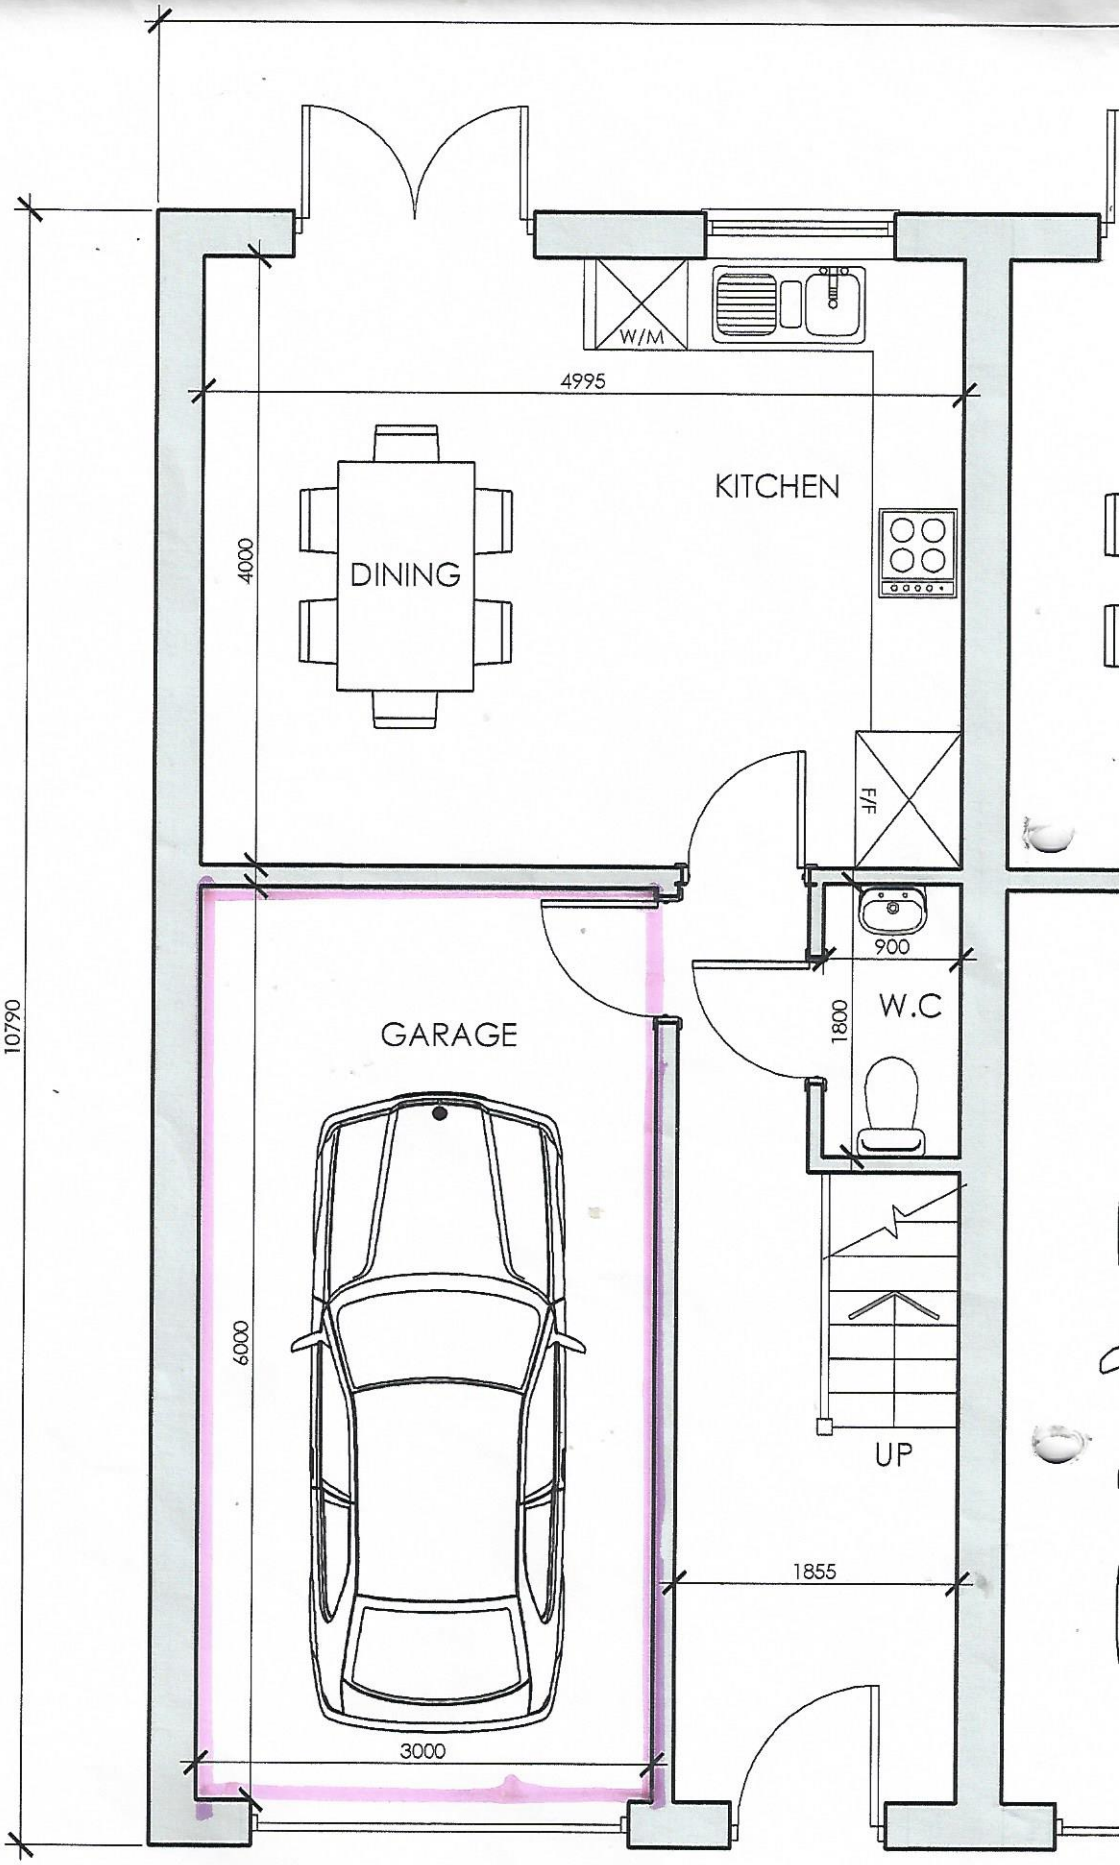


ALF:-
14-068
DRW 01

EXISTING
~~Proposed~~ Ground Floor Plan

scale 1:50

REF 14-068
DRW - 02

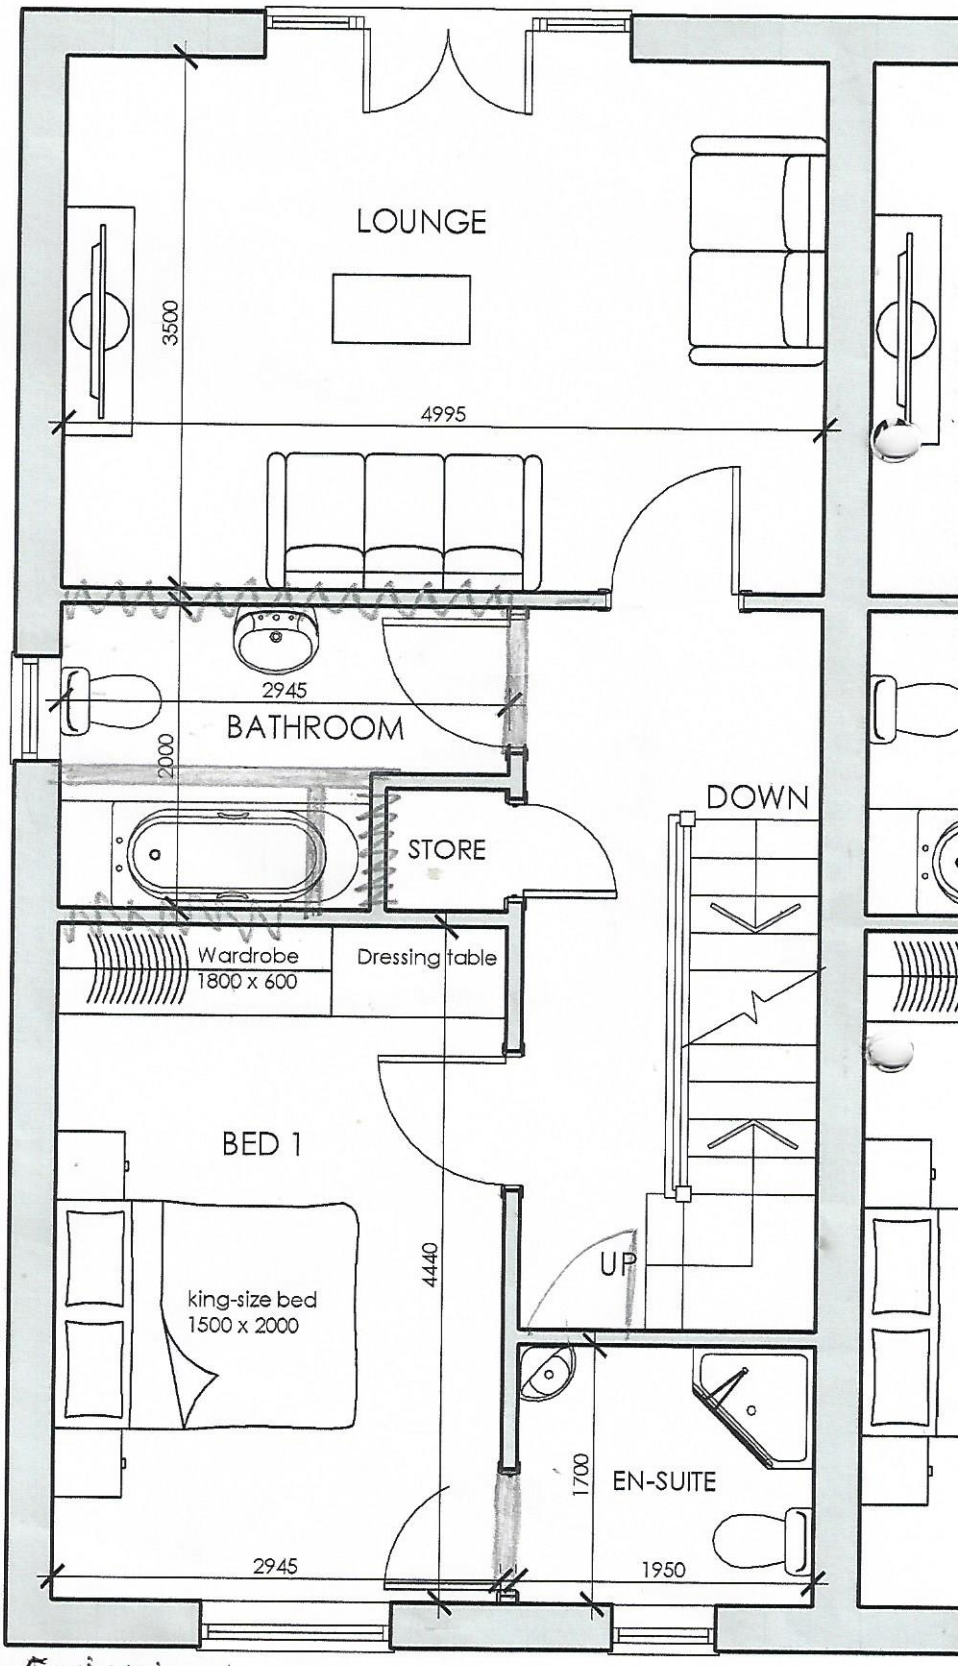

Existing

~~Proposed~~ First Floor Plan

scale 1:50

REF 14-068 DRW-03



RET 14-068

BRW - 04

~~Proposed~~ EXISTING Front Elevation

scale 1:50



RET 14-068

BRW - 07

~~Proposed~~ Front Elevation

scale 1:50


Drawing No.	Rev No.
MIJ001 -001	

DO NOT SCALE: Contractor to check all dimensions and report any omissions or errors

NOTES



INDICATIVE ONLY

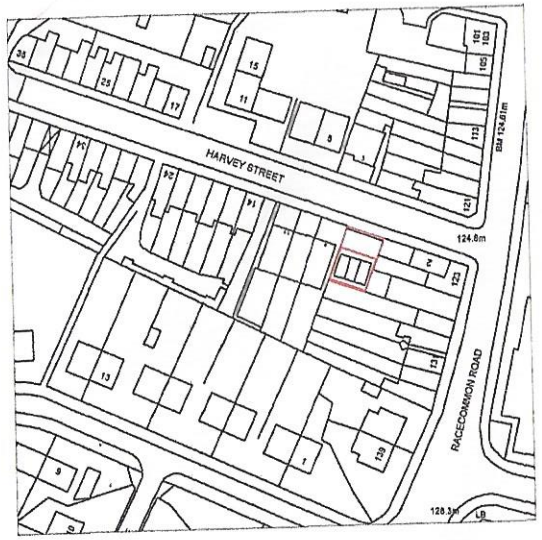

LOACATION PLAN
SCALE 1:1250 AT A3



SITE PLAN
SCALE 1:500 AT A3

Rev	Description	By	Chk	App	Date

JRB DESIGNS Ltd
1 Saville Road
Cudworth
Barnsley
S72 8LT
Tel: 01226 383542
Fax: 01226 380078
Mob: 07970 541192
Email: johnr@jrbdesigns.co.uk

This drawing is copyright. © jrbdesigns Ltd.

Client: MR. I JACKSON

Drawing Title: SITE PLANS

Address: GARAGES ON HARVEY STREET
BARNSLEY
SOUTH YORKSHIRE
S70 6JX

Project Title: PROPOSED REPLACEMENT GARAGES

Purpose of Issue: PLANNING

Drawing Status: FIRST ISSUE

Scale at A3	Drawn By	Date
AS SHOWN	JRB	08/11/2018
Checked By	Date	Approved By / Date
	08/11/2018	08/11/2018
Project No.	Drawing No.	Revision
MIJ001	001	-

APPROVAL ☒ INFORMATION ☐ TENDER ☐ CONTRACT ☐ CONSTRUCTION ☐

REF 14-068
DRW-06