




SITE PLAN 1:200 @ A1

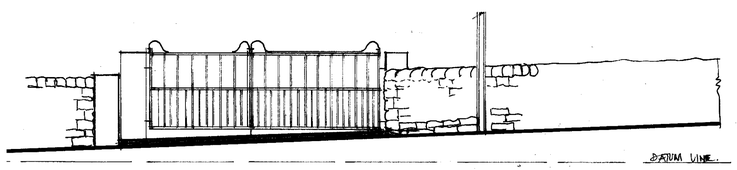

BARNSLEY ROAD ELEVATION AS BUILT 1:50

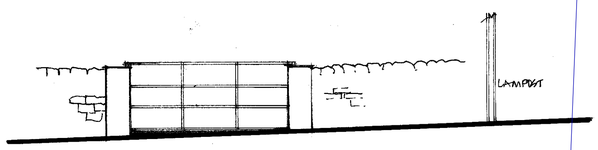

EXISTING GATED ENTRANCE 1: 50

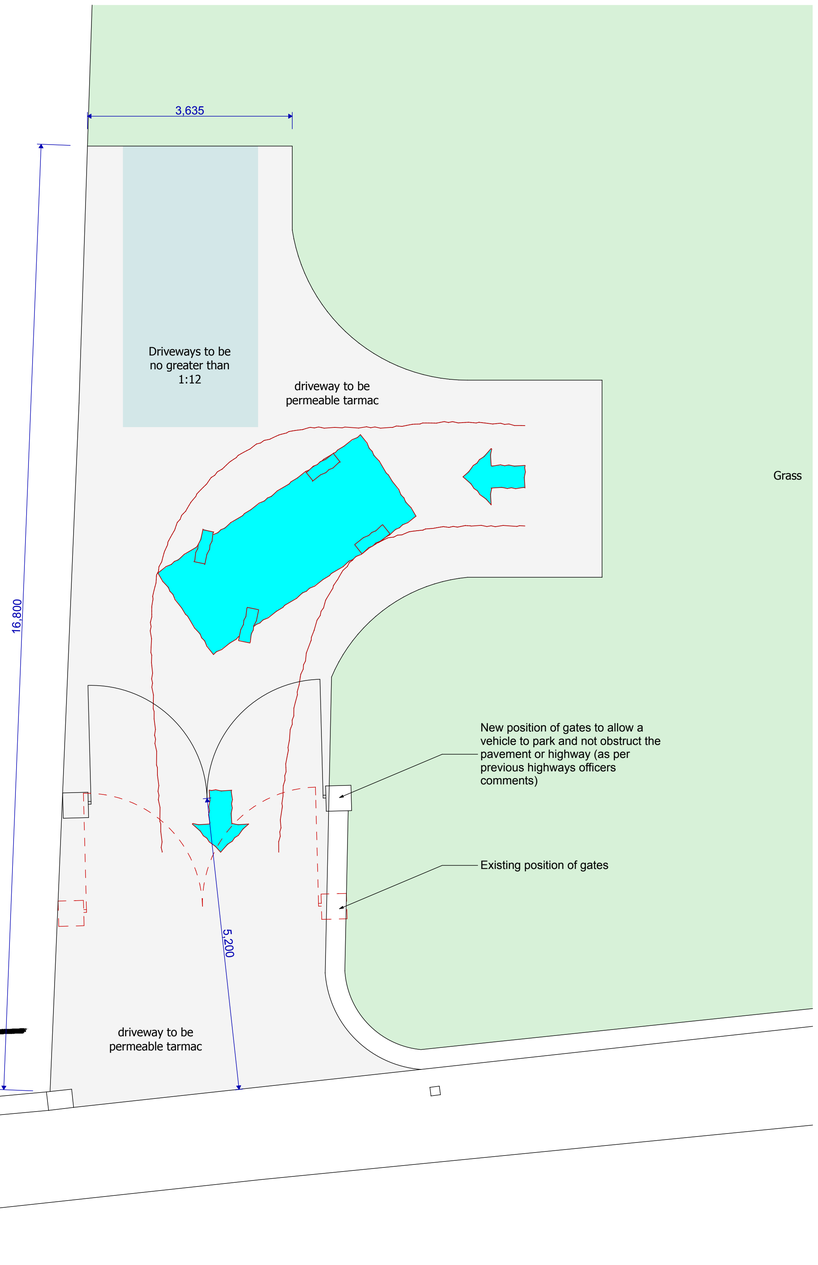

PROPOSED SITE PLAN 1:50 @ A1

Drawing and design are copyright of Dzign House Architecture ltd unless specific consent in writing has been given. All works arising from the information contained on the drawings are to be in accordance with the statuary approvals for planning, building control and relevant codes of practice and/or British Standards unless specific direction is given. All works to be carried out in accordance with c.d.m. regulations for health and safety. Construction (Design and Management) Regulations also require that a principle designer is appointed for each project, we do not undertake this role unless agreed in writing prior to commencement of works. This can be undertaken by the client (domestic) or an individual principle designer to be otherwise appointed. Do not scale or take digital dimensions from this drawing. All constructional dimensions contained in the drawings should be checked on site prior to construction. Calculations and sizes for all structural elements to be provided by a structural engineer to the Building Control Officer and contractor prior to commencement of works
Any discrepancies should be notified to the practice without delay.

© DZIGN HOUSE ARCHITECTURE LIMITED 01132400012

Date	Revision	Rev No.

Project
Retention of existing access from Barnsley Road with new recess and gates

Drawing Description
Site plan and elevs

Drawing No.
248-01

Scale
1:50 & 1:200 @ A1

Date
Jun 20

Client
Macey Construction ltd

Dzign.House architecture