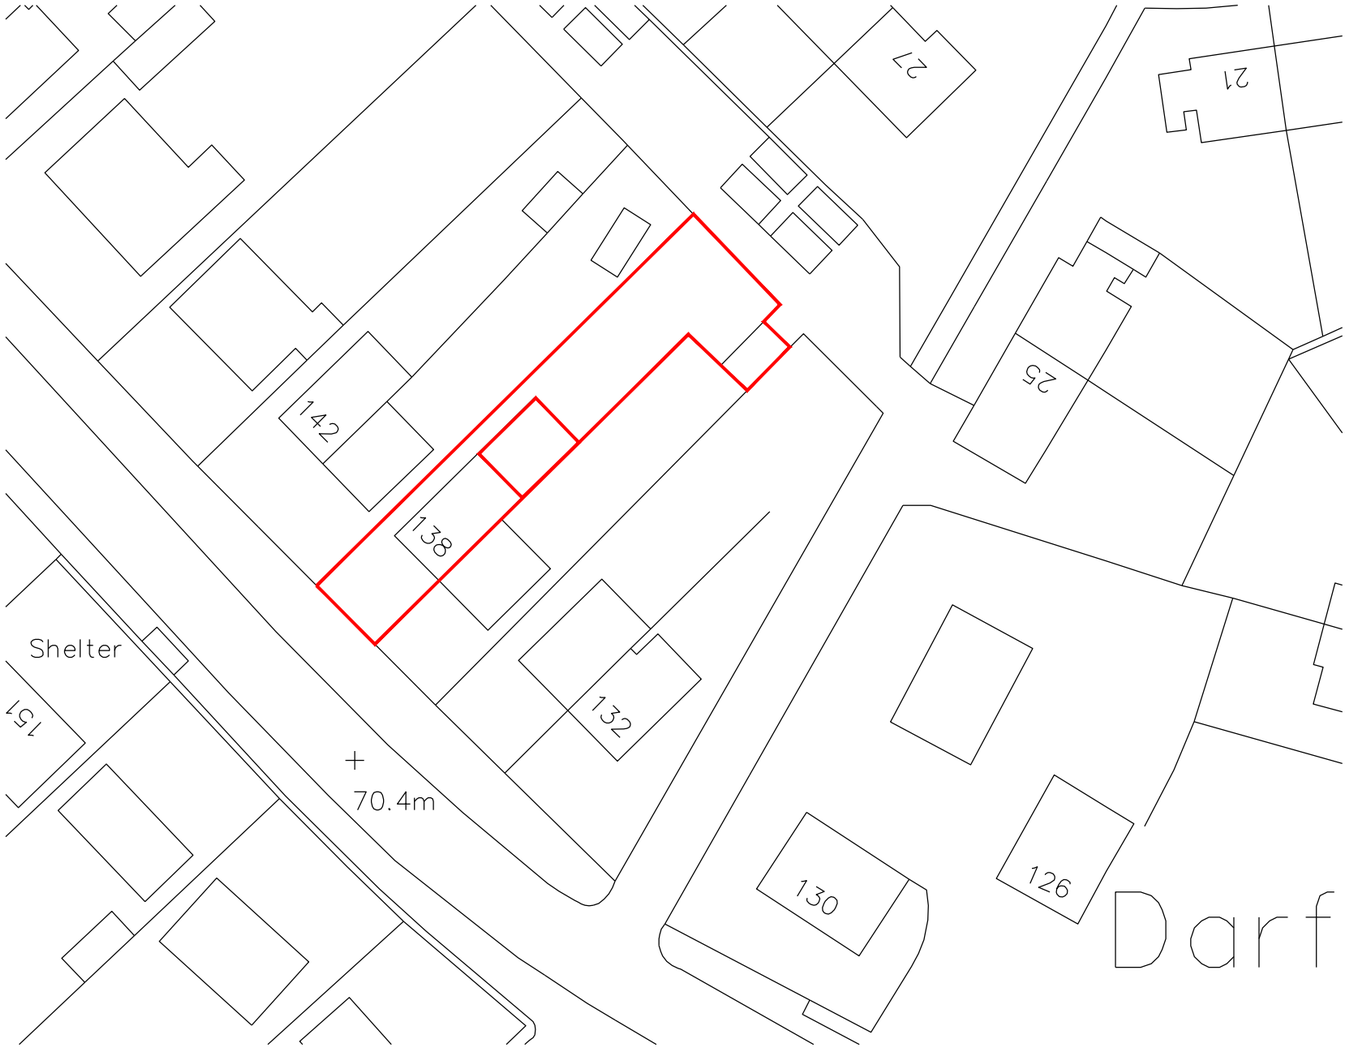

Revisions	A. Redline amended		24-05-23
This drawing is for planning permission only and is not a construction drawing.			
Drawing Title	BLOCK-PLAN		
Job No. - Dwg No.	CW/2023/09	.	–
Client:	CHRIS WOOD 138 BARNSLEY ROAD DARFIELD BARNSLEY S73 9DG		
Scale.	1:500		