

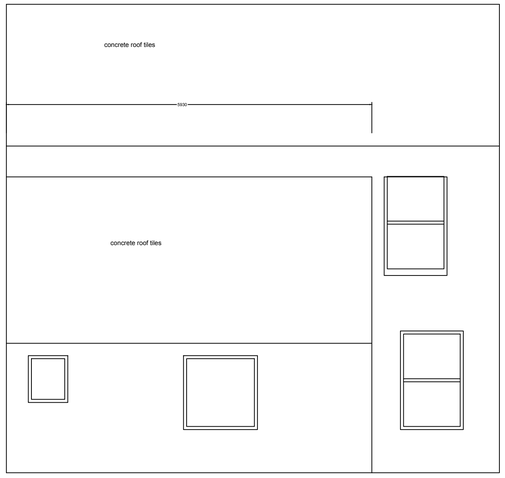


Existing rear elevation

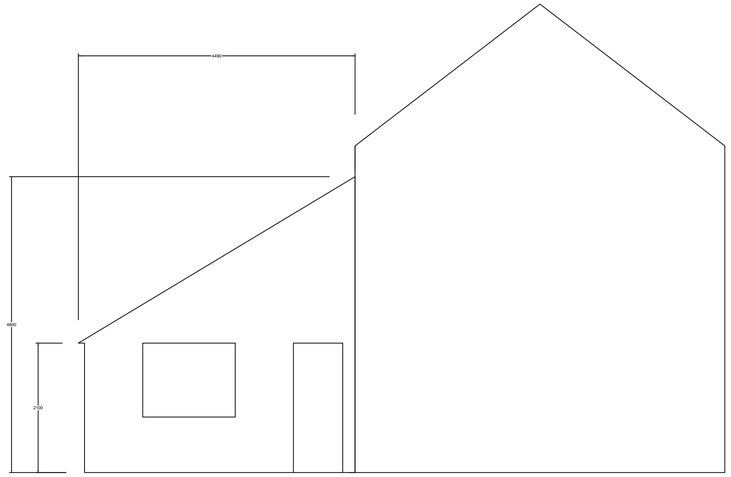


Existing side elevation

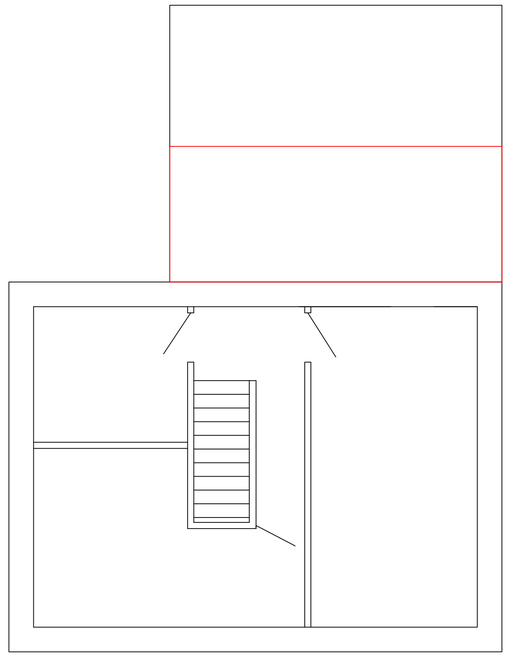


Current 1st Floor plan (showing Dormer position)


NEW WORK SHOWN IN RED

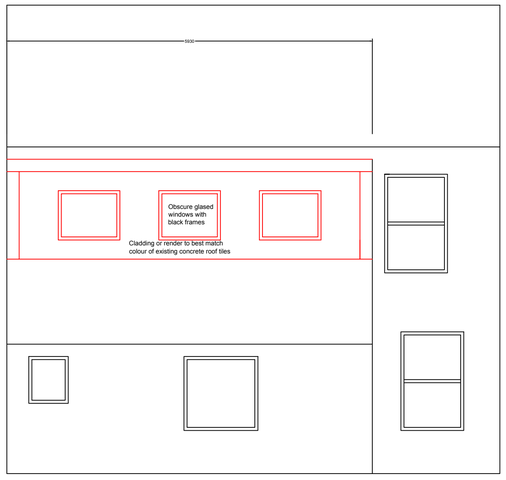

Proposed extention rear elevation

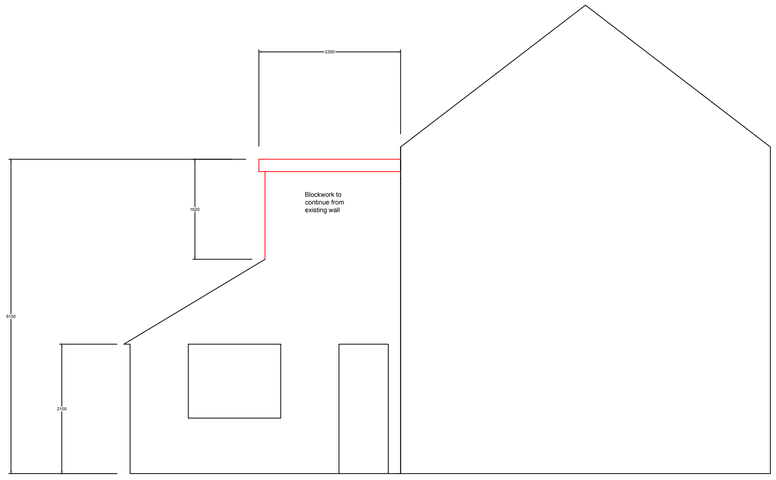

Proposed extention side elevation

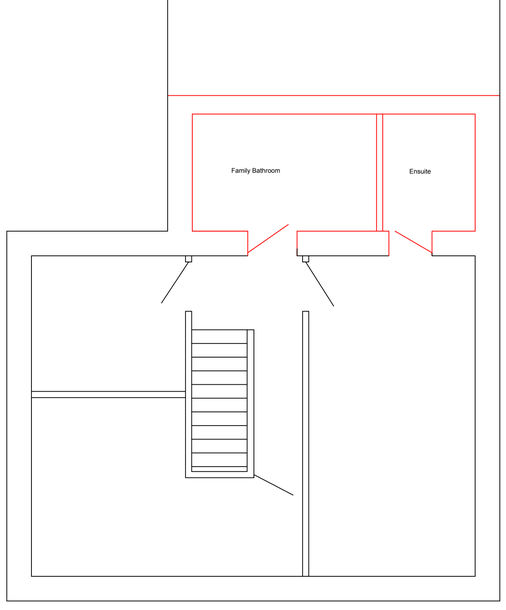

Proposed 1st floor plan

Mr Eaton Smithy House Smithy Hill Thurgoland	Plans & Elevations Scale 1:50 @ A1	
Application Ref PP-07331380v2		