
APPLICANT: D^R E W HARPER
LEIGH FARMHOUSE, LEIGH RD
BRADFORD ON AVON, WILTS
BA15 2RQ

83/85 HIGH ST GT HOUGHTON. GROUND FLOOR

THE TWO DOORWAYS MARKED IN RED ARE TO BE BLOCKED UP TO RETURN 83/85 BACK TO THE TWO RESIDENCES 83 HIGH ST AND 85 HIGH ST.

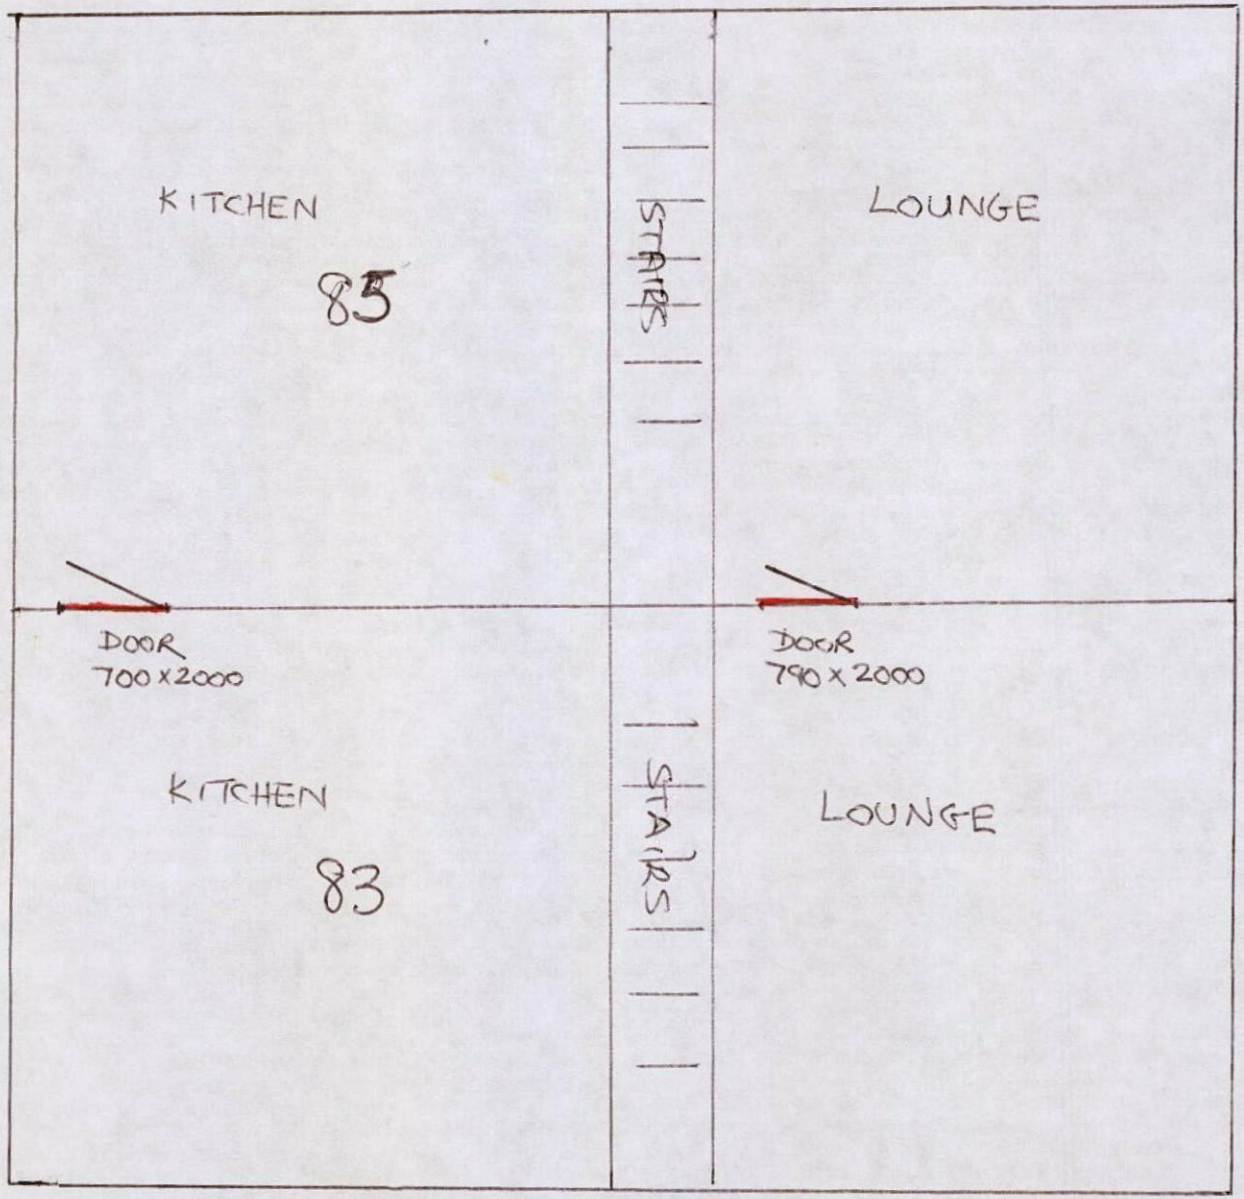

0 1m 2m

Scale 1:50