LAND WHICH PLANNING RELATES

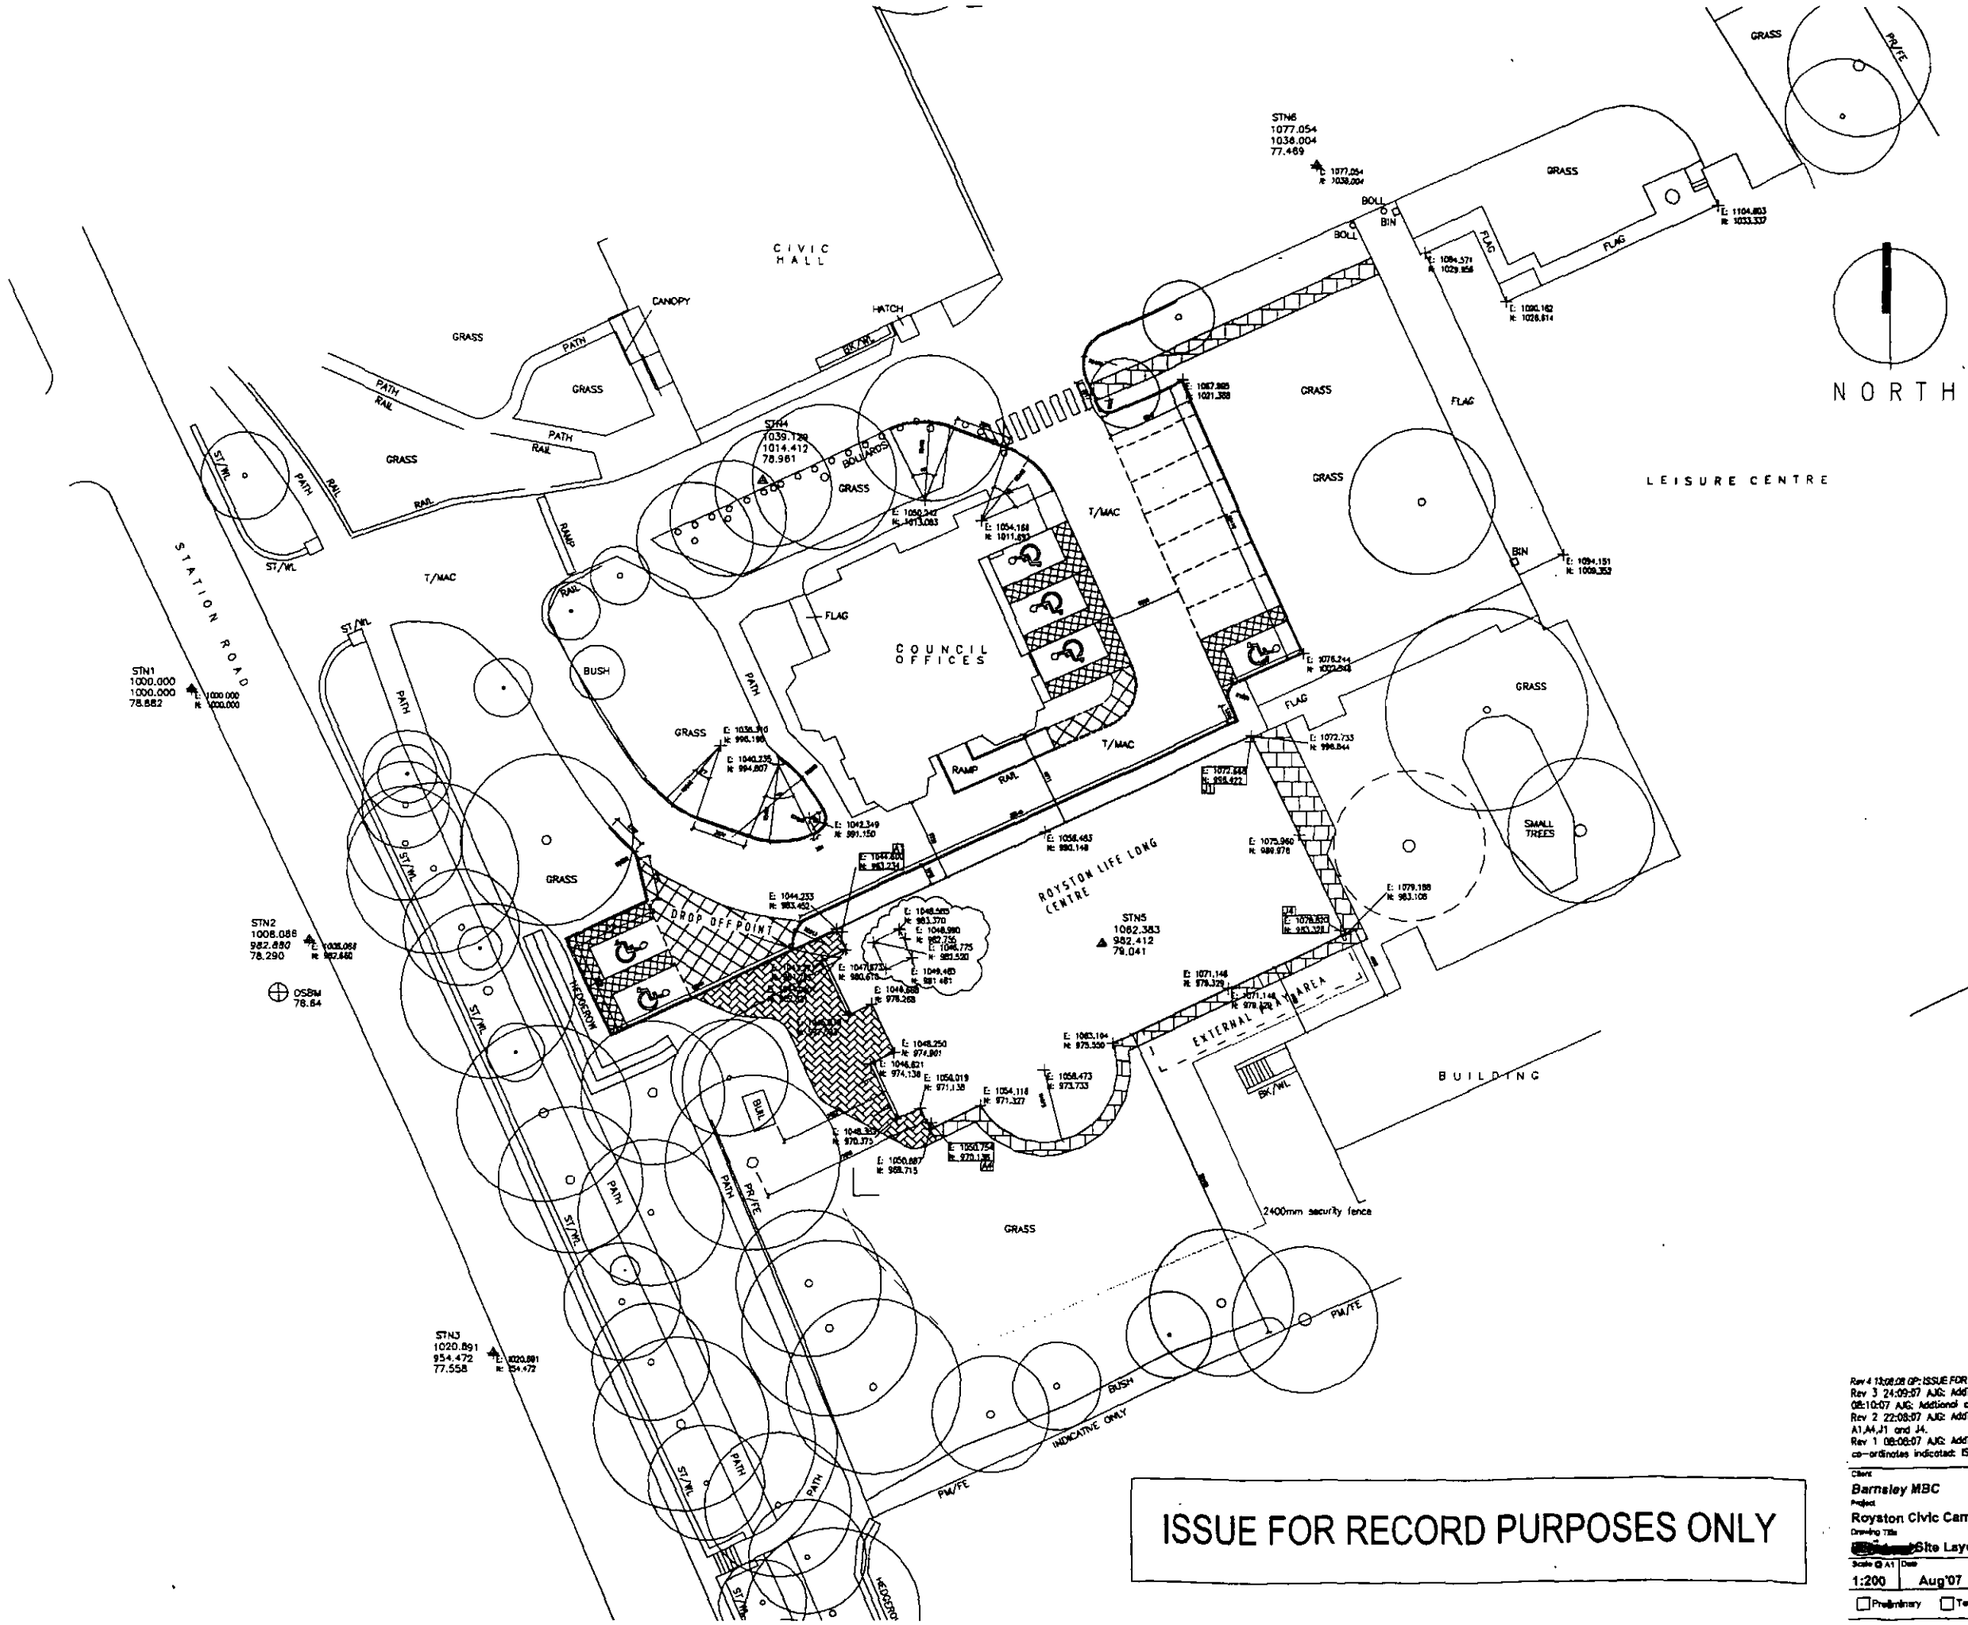

ISSUE FOR RECORD PURPOSES ONLY

PHS

PHS ARCHITECTS

Queens House
34 Wellington Street
Leeds
LS1 2DE
Tel +44 (0)113 245 4222
Fax +44 (0)113 245 6767
E-mail leeds@phsarchitects.co.uk

Rev 4 13:08:08 GP: ISSUE FOR RECORD PURPOSES ONLY
Rev 3 24:09:07 AJG: Additional co-ords added to lift shaft.
08:10:07 AJG: Additional co-ords added to lift shaft.
Rev 2 22:08:07 AJG: Additional co-ords added to Gridlines A1,A4,J1 and J4.
Rev 1 05:06:07 AJG: Additional site setting out dimensions and co-ordinates indicated: ISSUED FOR CONSTRUCTION.

Client
Barnsley MBC

Project
Royston Civic Campus, Lifelong Learning Centre

Drawing Title
[redacted] Site Layout

Do not scale off this drawing. Work to figured dimensions, and any discrepancy to be reported to the Architect. Refer to larger scale drawings where available. Copyright PHS Architects.

Scale @ A1	Date	Project number	CI/SfB Code	Drawing Number	Revision
1:200	Aug'07	1601	90	001	4

☐ Preliminary ☐ Tender ☒ Construction ☐ As built

Drawn	Checked
ajg	

PROPOSED SIGN LOCATION DRAWING

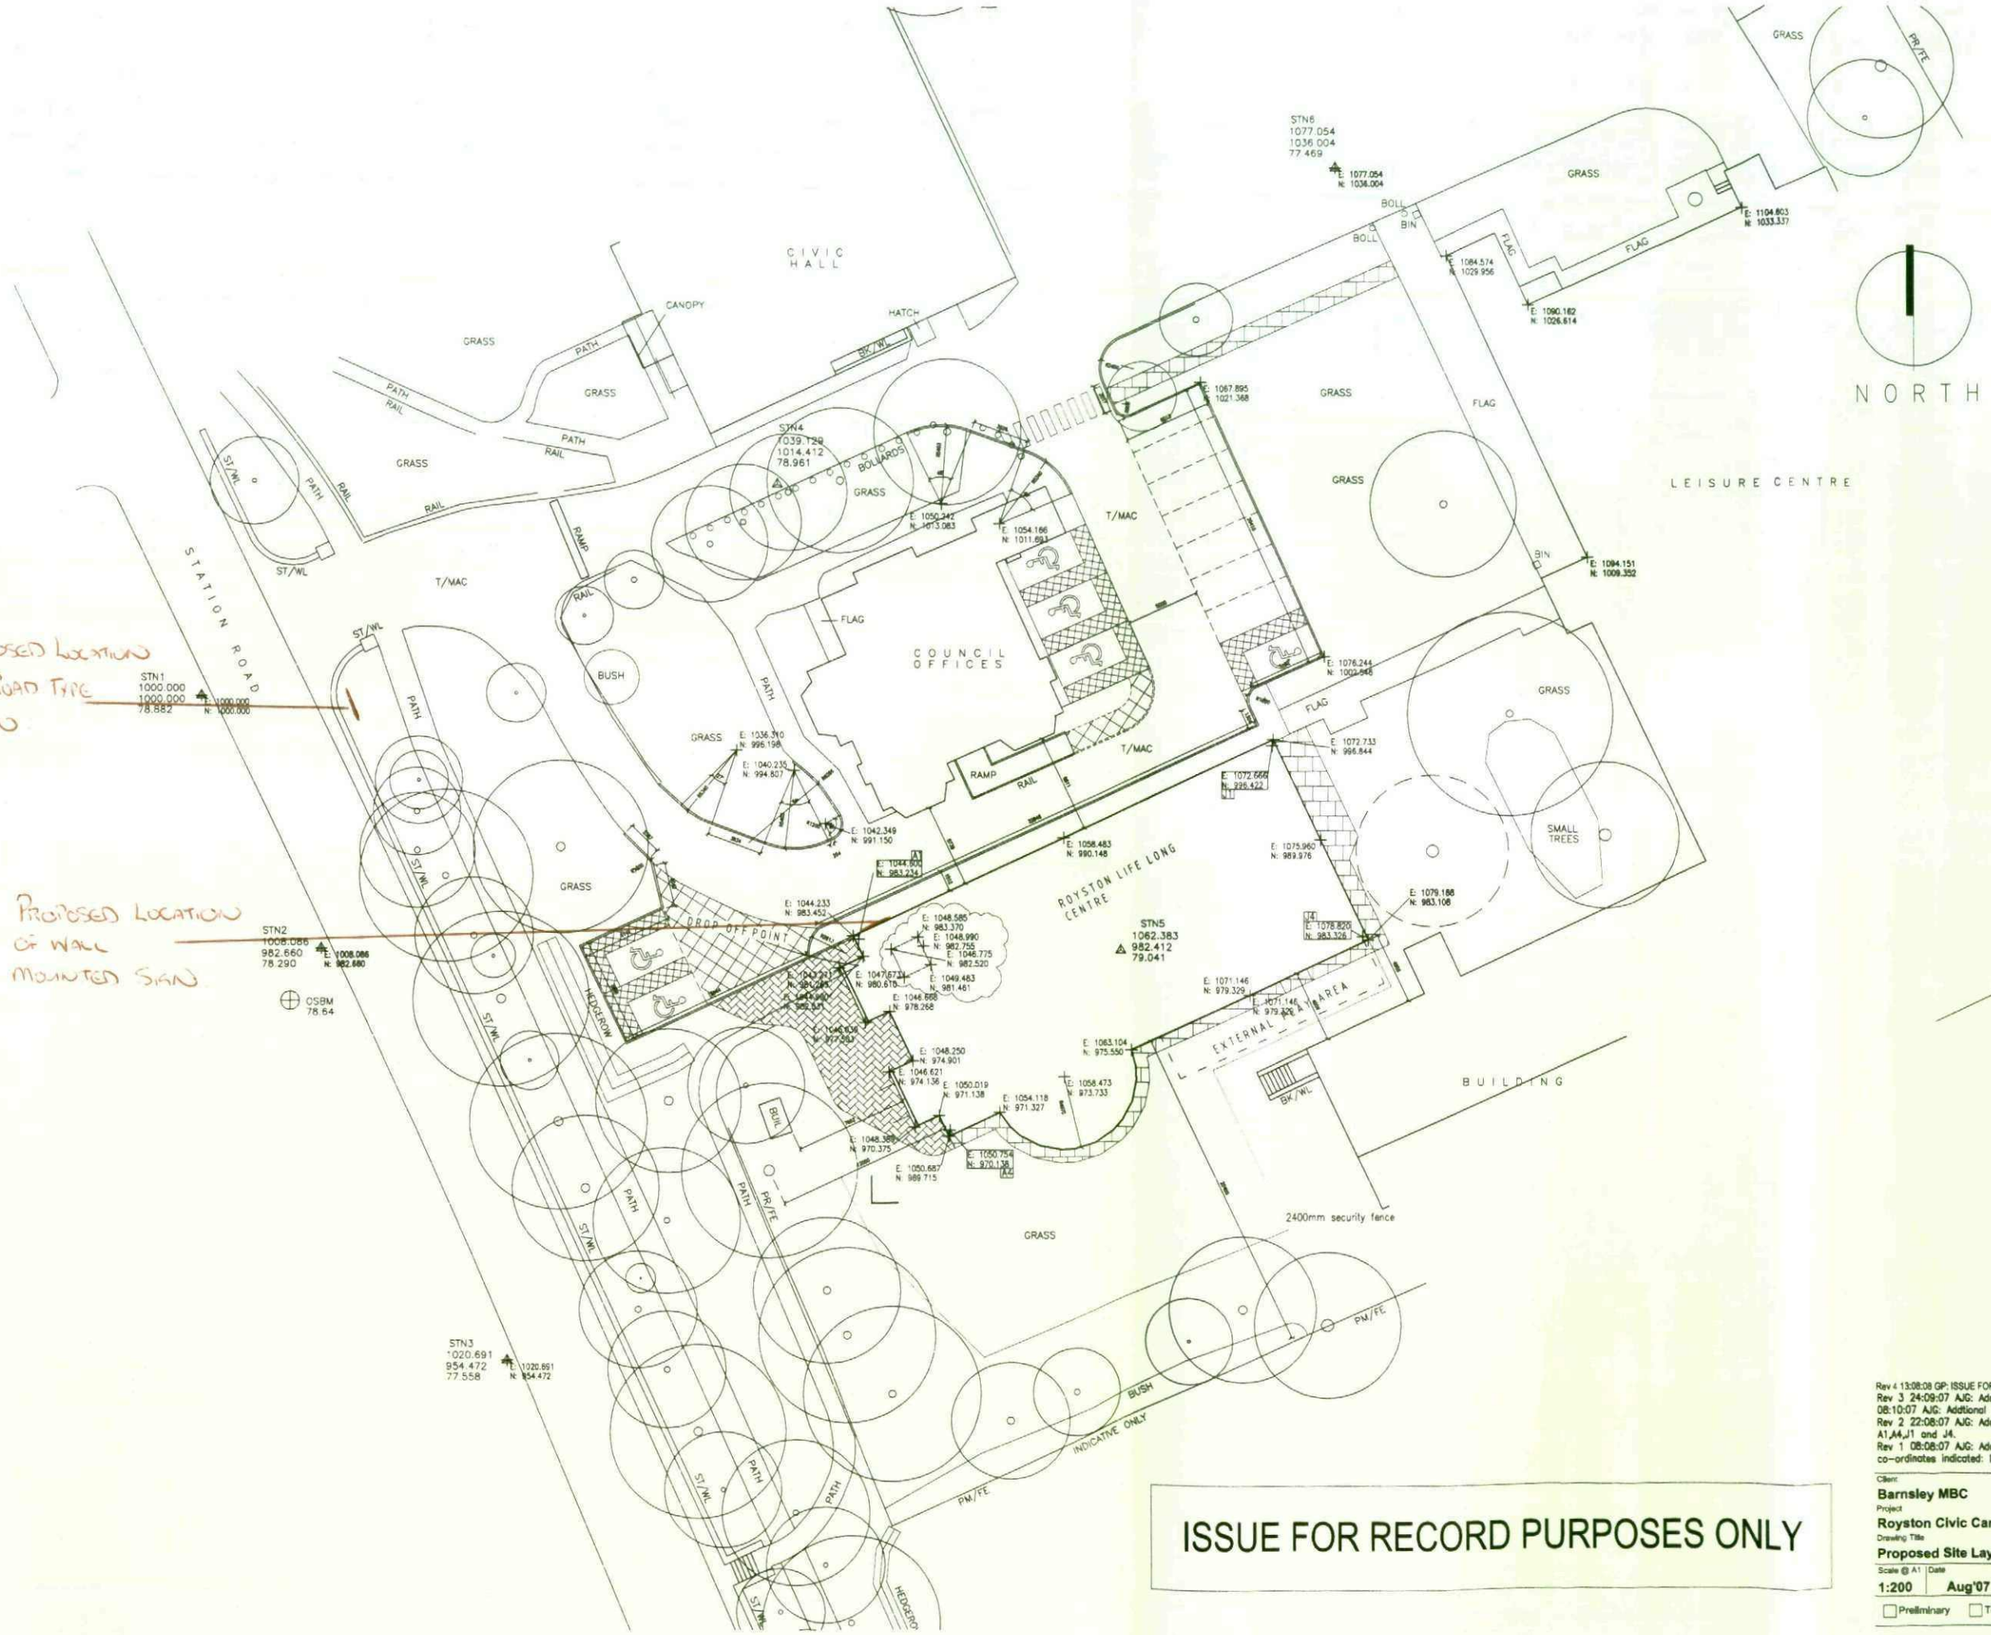

ISSUE FOR RECORD PURPOSES ONLY

PHS

PHS ARCHITECTS

Queens House
34 Wellington Street
Leeds
LS1 2DE
Tel +44 (0)113 245 4332
Fax +44 (0)113 246 8767
E-mail leeds@phsarchitects.co.uk

Rev 4 13:08:08 GP: ISSUE FOR RECORD PURPOSES ONLY
Rev 3 24:09:07 AJG: Additional co-ords added to lift shaft.
08:10:07 AJG: Additional co-ords added to lift shaft.
Rev 2 22:08:07 AJG: Additional co-ords added to Gridlines A1,A4,J1 and J4.
Rev 1 08:08:07 AJG: Additional site setting out dimensions and co-ordinates indicated: ISSUED FOR CONSTRUCTION.

Client
Barnsley MBC
Project
Royston Civic Campus, Lifelong Learning Centre
Drawing Title
Proposed Site Layout

Do not scale off this drawing. Work to figured dimensions and any discrepancy to be reported to the Architect. Refer to larger scale drawings where available. Copyright PHHS Architects.

Scale @ A1	Date	Project number	CI/SfB Code	Drawing Number	Revision
1:200	Aug'07	1601	90	001	4

☐ Preliminary ☐ Tender ☒ Construction ☐ As built — Drawn: ajg — Checked: