WYG Planning & Design

part of the **WYG** group

DC
Barnsley Metropolitan Borough Council
02 FEB 2009
Corporate Mail Room
NO CHQ

Ref: NT/A035220-2
Email: nolan.tucker@wyg.com
Direct Dial: 0113 219 2247

30th January 2008

Mr. K. Dunn
Barnsley Metropolitan Borough Council
Westgate Plaza
Town Hall
Barnsley
S70 2TA

Dear Keiron,

Mixed Use Development – Part of the Former Houghton Main Colliery, Little Houghton (App Ref: 2009/0070)

As discussed, please find enclosed a slight amendment to the red line boundary in connection with the above application (4 copies). You will note that this does not impact upon the development proposals set out in illustrative form on the masterplan. We have also included the line of the Green Belt boundary on the plan for your information, which demonstrates that the application site falls entirely outside the Green Belt.

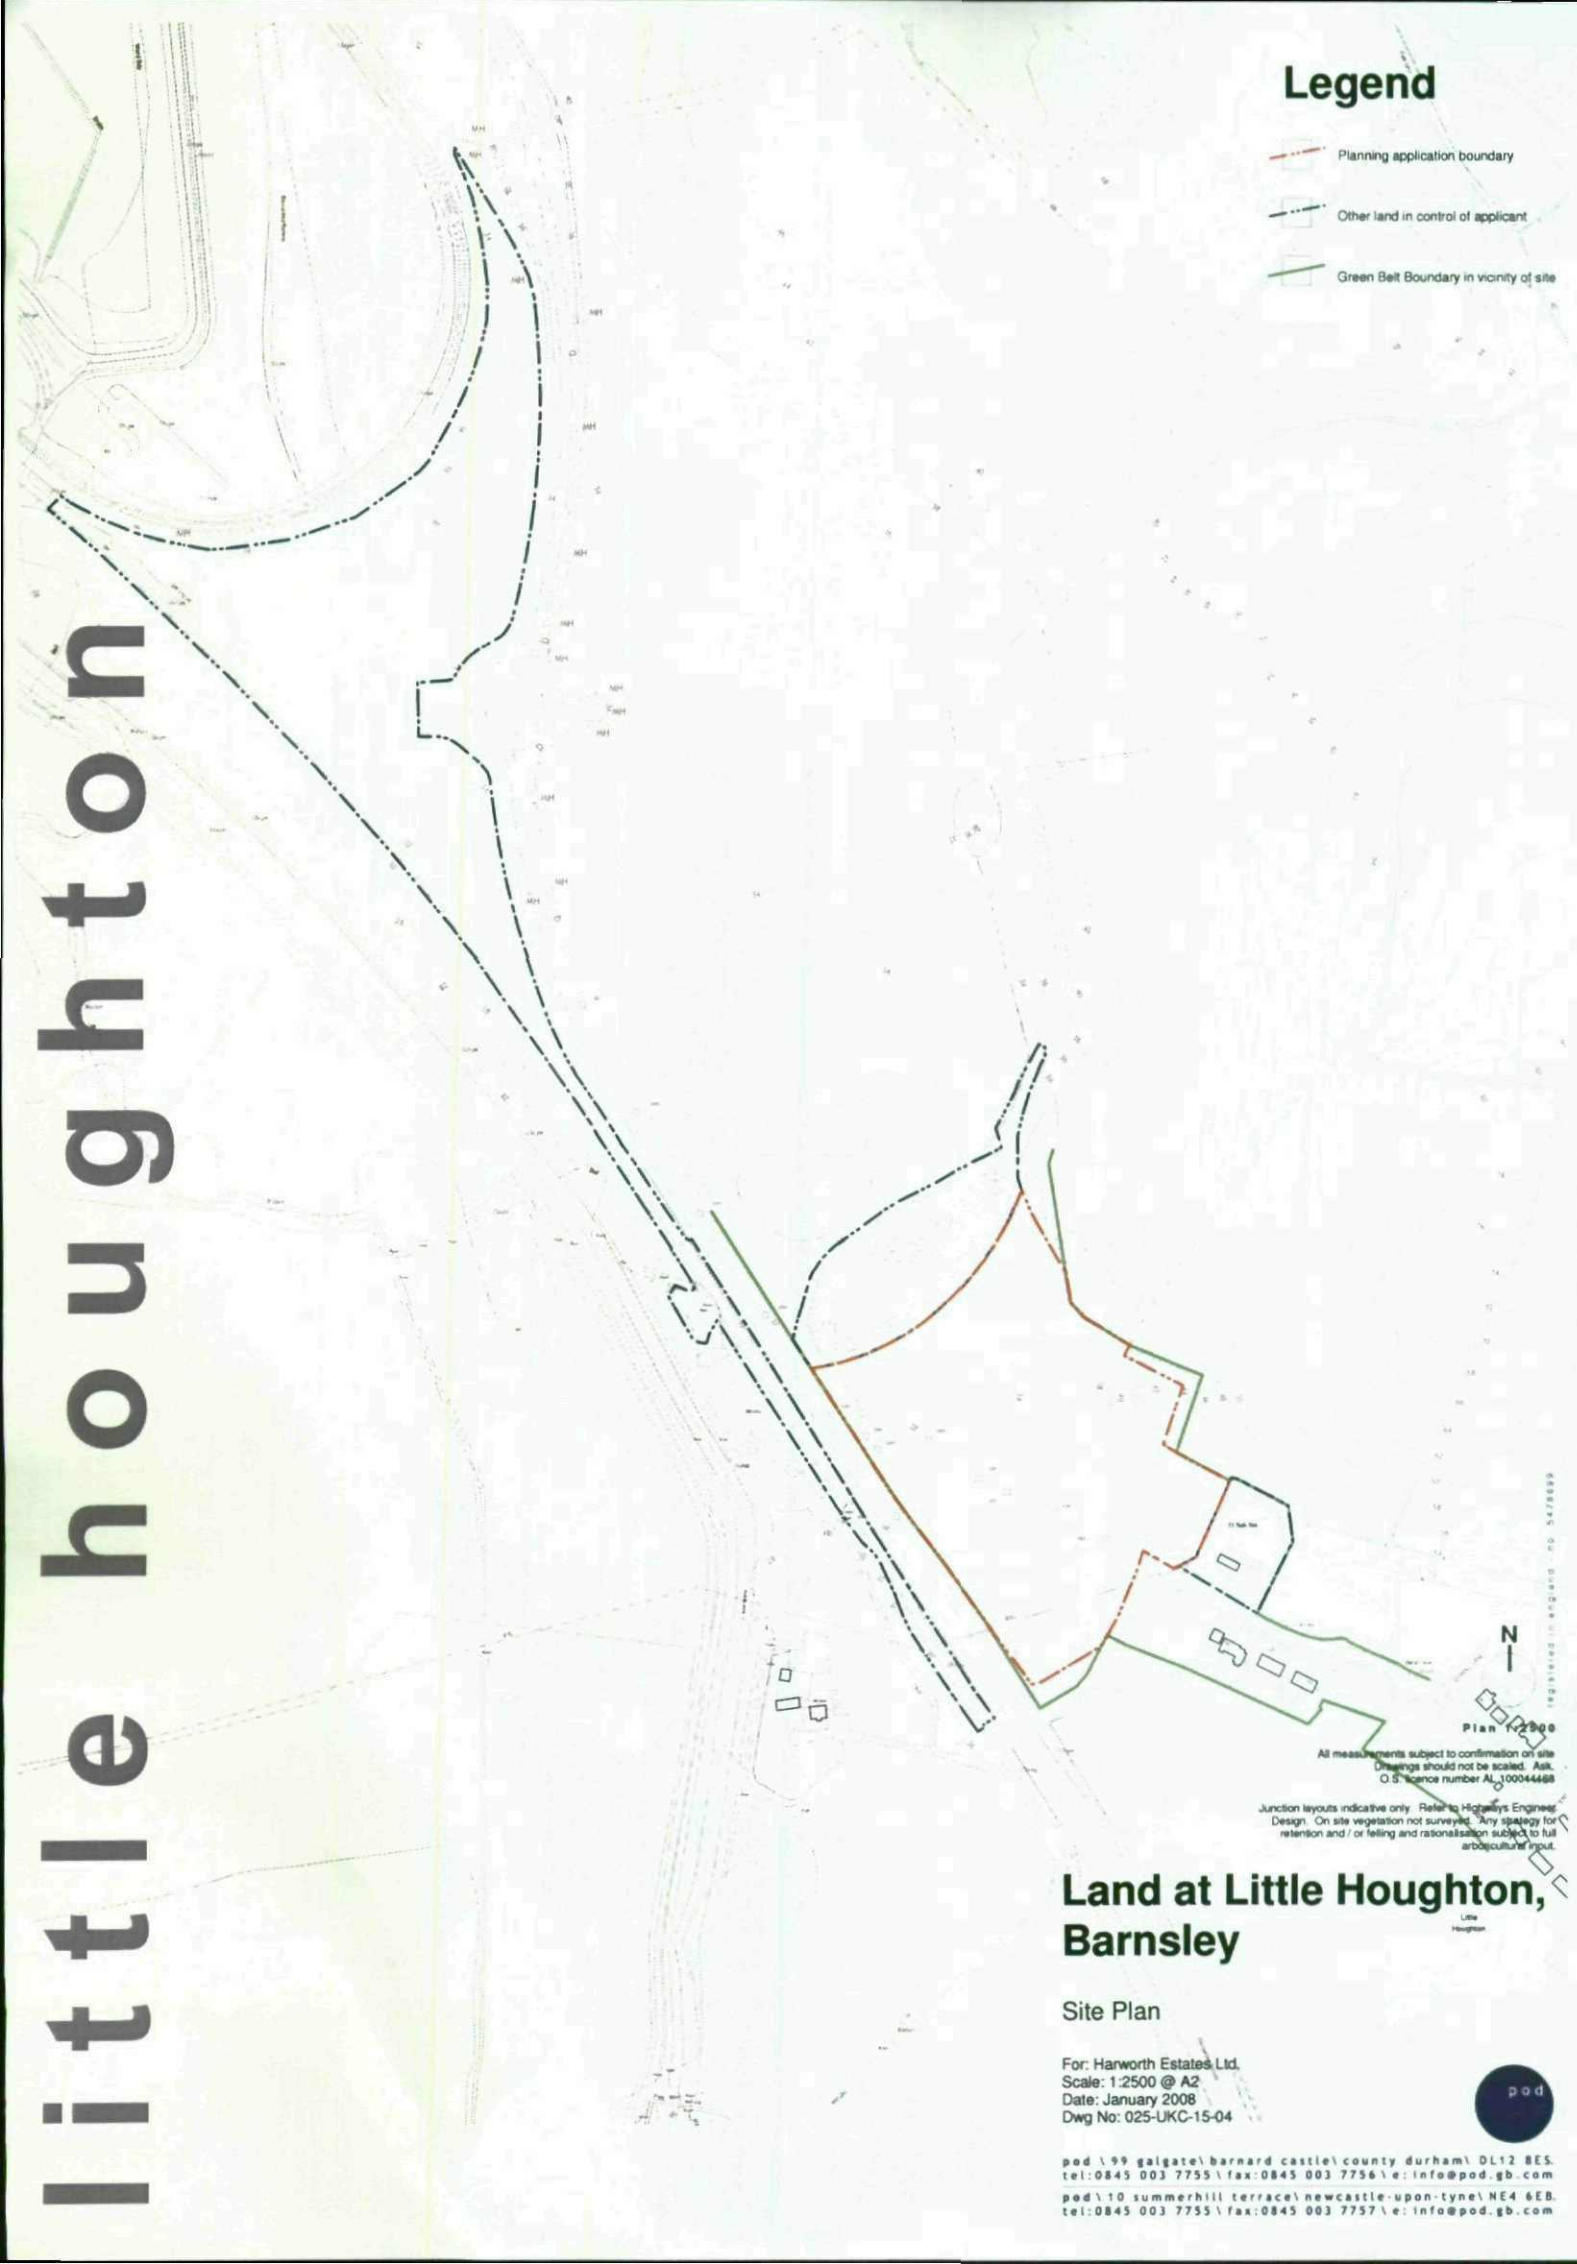
Should you have any questions, please do not hesitate to contact me.

Yours sincerely

[redacted]

Nolan Tucker
Associate Director

cc. A. Murray, Harworth Estates


little houghton
Legend
Planning application boundary
Other land in control of applicant
Green Belt Boundary in vicinity of site
N
Plan 1:2500
All measurements subject to confirmation on site
Drawings should not be scaled. Ask.
O.S. licence number AL 100044668
Junction layouts indicative only. Refer to Highways Engineer Design. On site vegetation not surveyed. Any strategy for retention and / or felling and rationalisation subject to full arboricultural input.
Land at Little Houghton, Barnsley
Little Houghton
Site Plan
For: Harworth Estates Ltd.
Scale: 1:2500 @ A2
Date: January 2008
Dwg No: 025-UKC-15-04
pod
pod \ 99 galgate \ barnard castle \ county durham \ DL12 8ES.
tel:0845 003 7755 \ fax:0845 003 7756 \ e: info@pod.gb.com
pod \ 10 summerhill terrace \ newcastle-upon-tyne \ NE4 6EB.
tel:0845 003 7755 \ fax:0845 003 7757 \ e: info@pod.gb.com