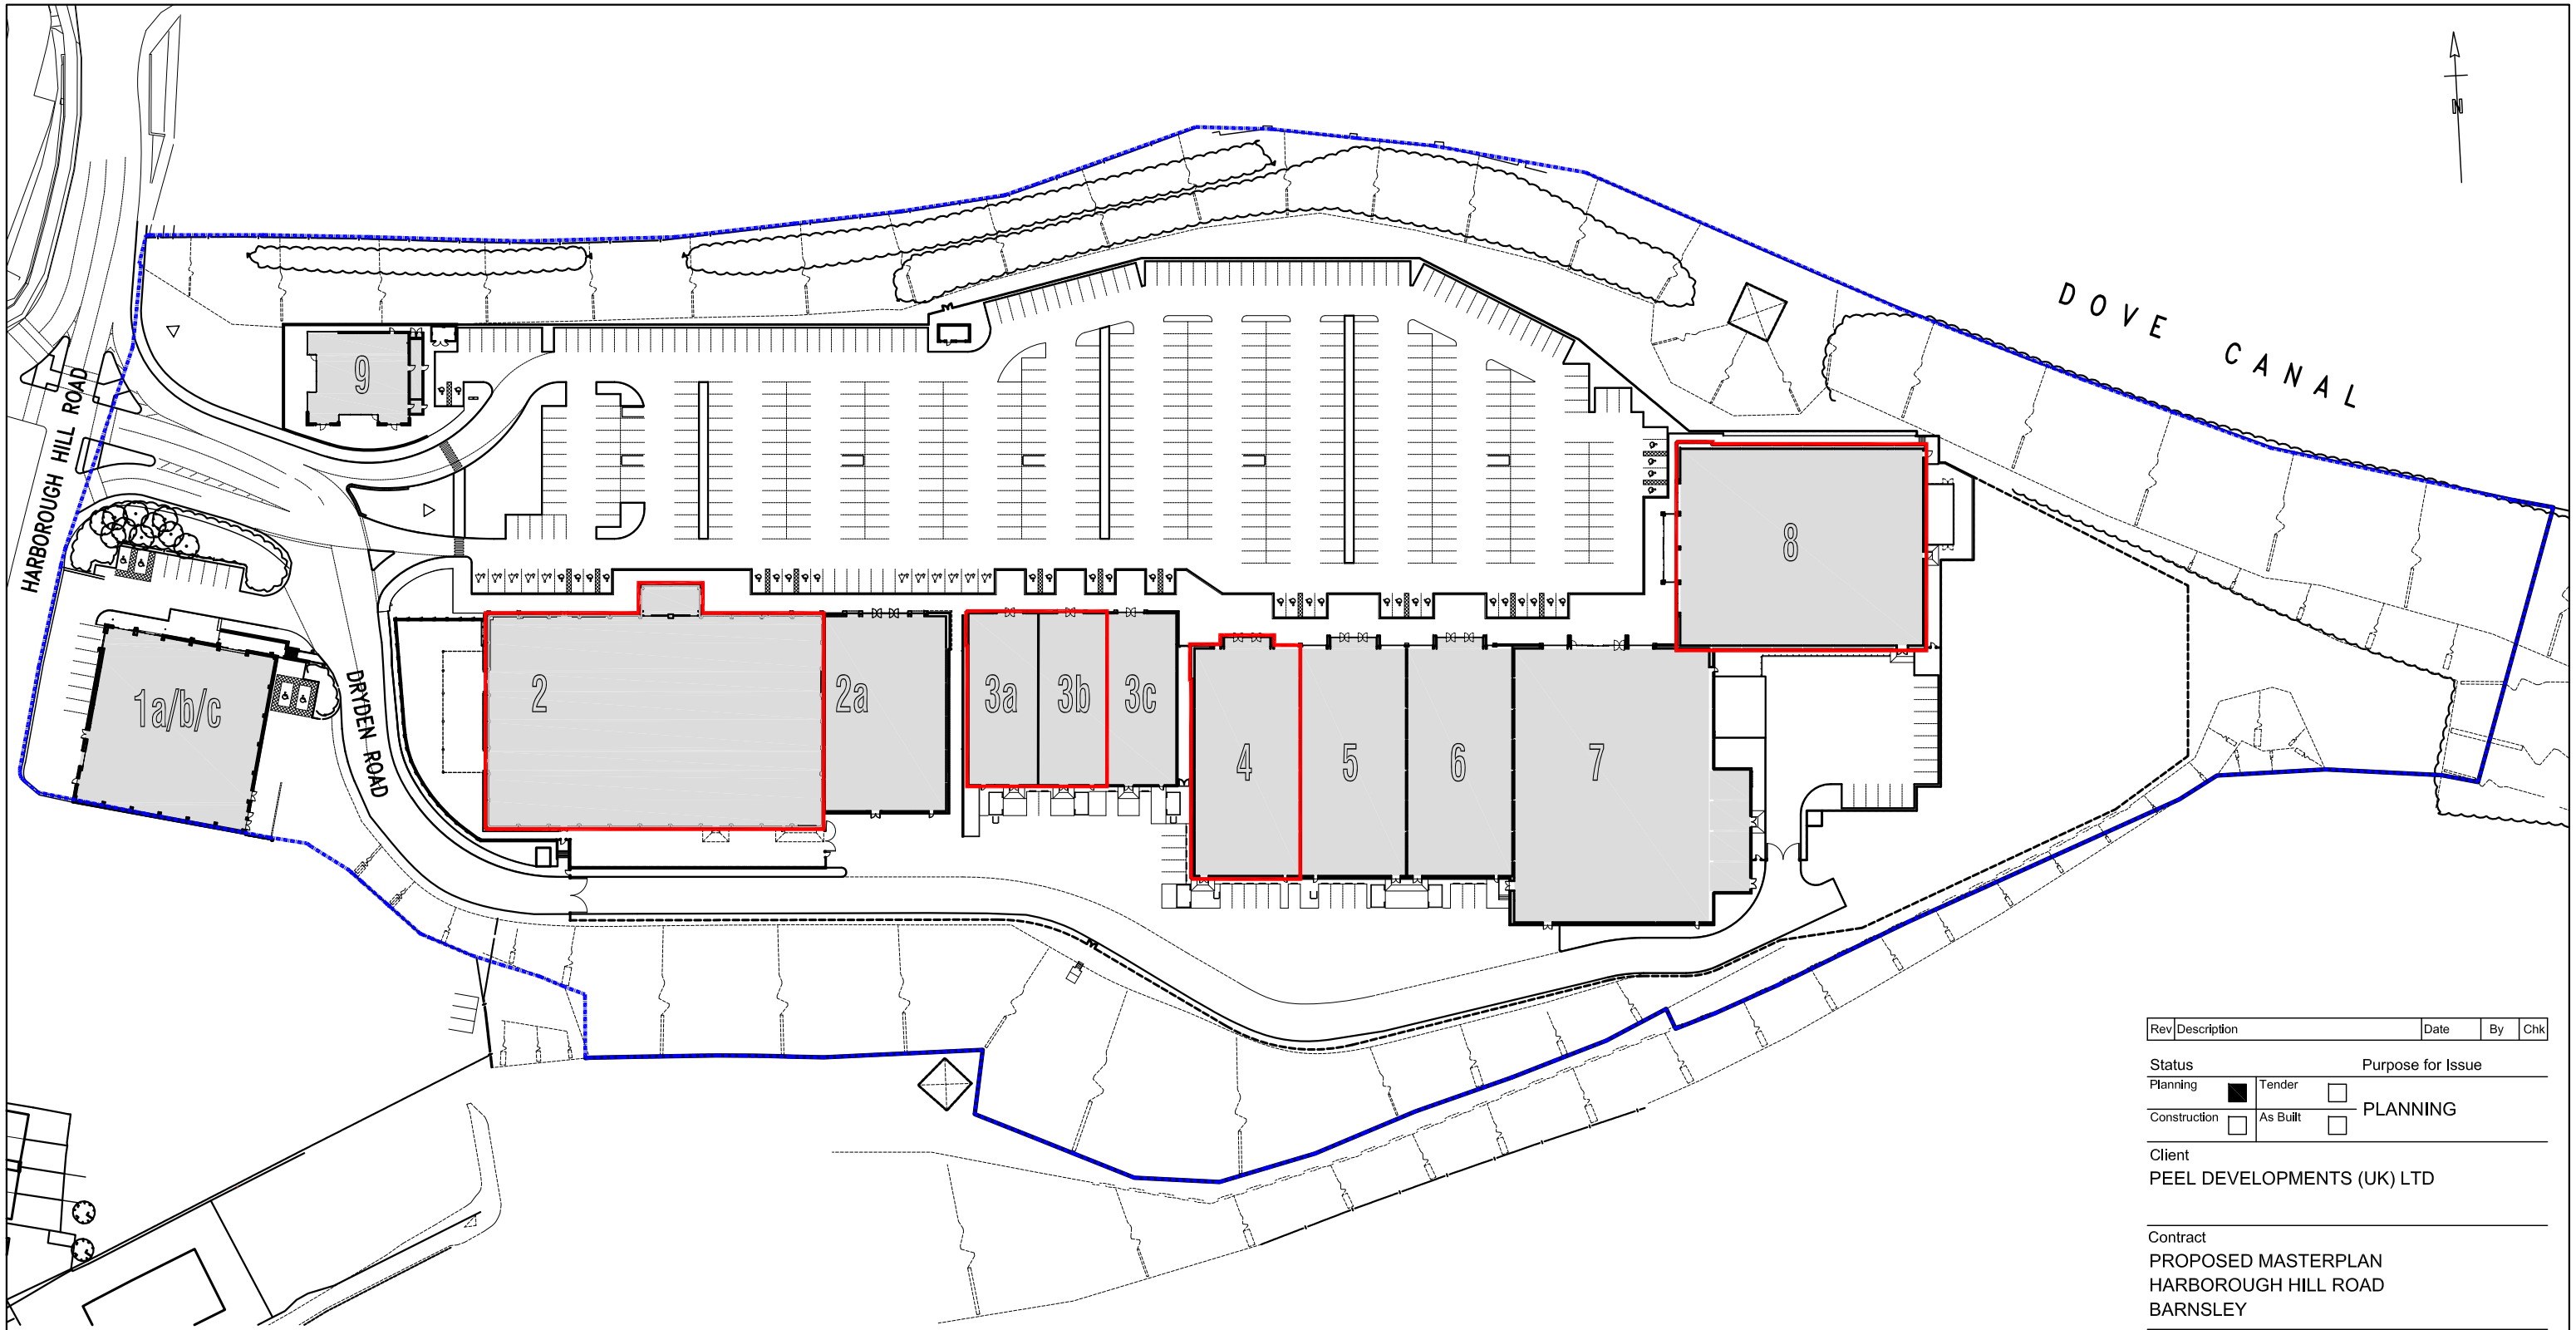


01 Proposed Unit 2, 3, 4, 8 Variations

Scale 1:1250 @ A3

Rev	Description	Date	By	Chk

Status: Purpose for Issue

Planning ■ Tender ☐ Construction ☐ As Built ☐ — PLANNING

Client
PEEL DEVELOPMENTS (UK) LTD

Contract
PROPOSED MASTERPLAN
HARBOROUGH HILL ROAD
BARNSLEY

Drawing
PROPOSED UNIT 2, 3, 4, 8 VARIATIONS

bateandtaylor architects
www.bate-taylor.co.uk
macintosh house
4a cambridge street
manchester m1 5gg
tel: 0161 236 0999
fax: 0161 236 0404
mail@bate-taylor.co.uk

Drawing No.	MH973-03	Revision	/
Scales	1:1250 @ A3	Date	JUNE '15
Drawn	DL	Checked	GB

This drawing is the copyright of the Architect and may not be reproduced without licence.
DO NOT scale from this drawing.