IMPORTANT NOTE:

ALL DIMENSIONS AND LEVELS SHOWN ON THIS DRAWING ARE TO BE CHECKED BY THE CONTRACTOR/ MANUFACTURER PRIOR TO THE COMMENCEMENT OF ANY WORKS ON SITE OR THE MANUFACTURE OF ANY SITE COMPONENTS.


THIS DRAWING IS NOT TO BE SCALED.

DIMENSIONS ARE INDICATED IN MILLIMETRES UNLESS CLEARLY STATED OTHERWISE.

COPYRIGHT OF THIS DRAWING BELONGS SOLELY TO CUBE PSL.

LIMITATIONS & THIRD PARTY CLAUSE:

WHERE PARTS OF THE PROPERTY WERE COVERED, OR INACCESSIBLE AT TIME OF SURVEY, POSITIONS OF ELEMENTS ARE MARKED 'ASSUMED' ACCORDINGLY.

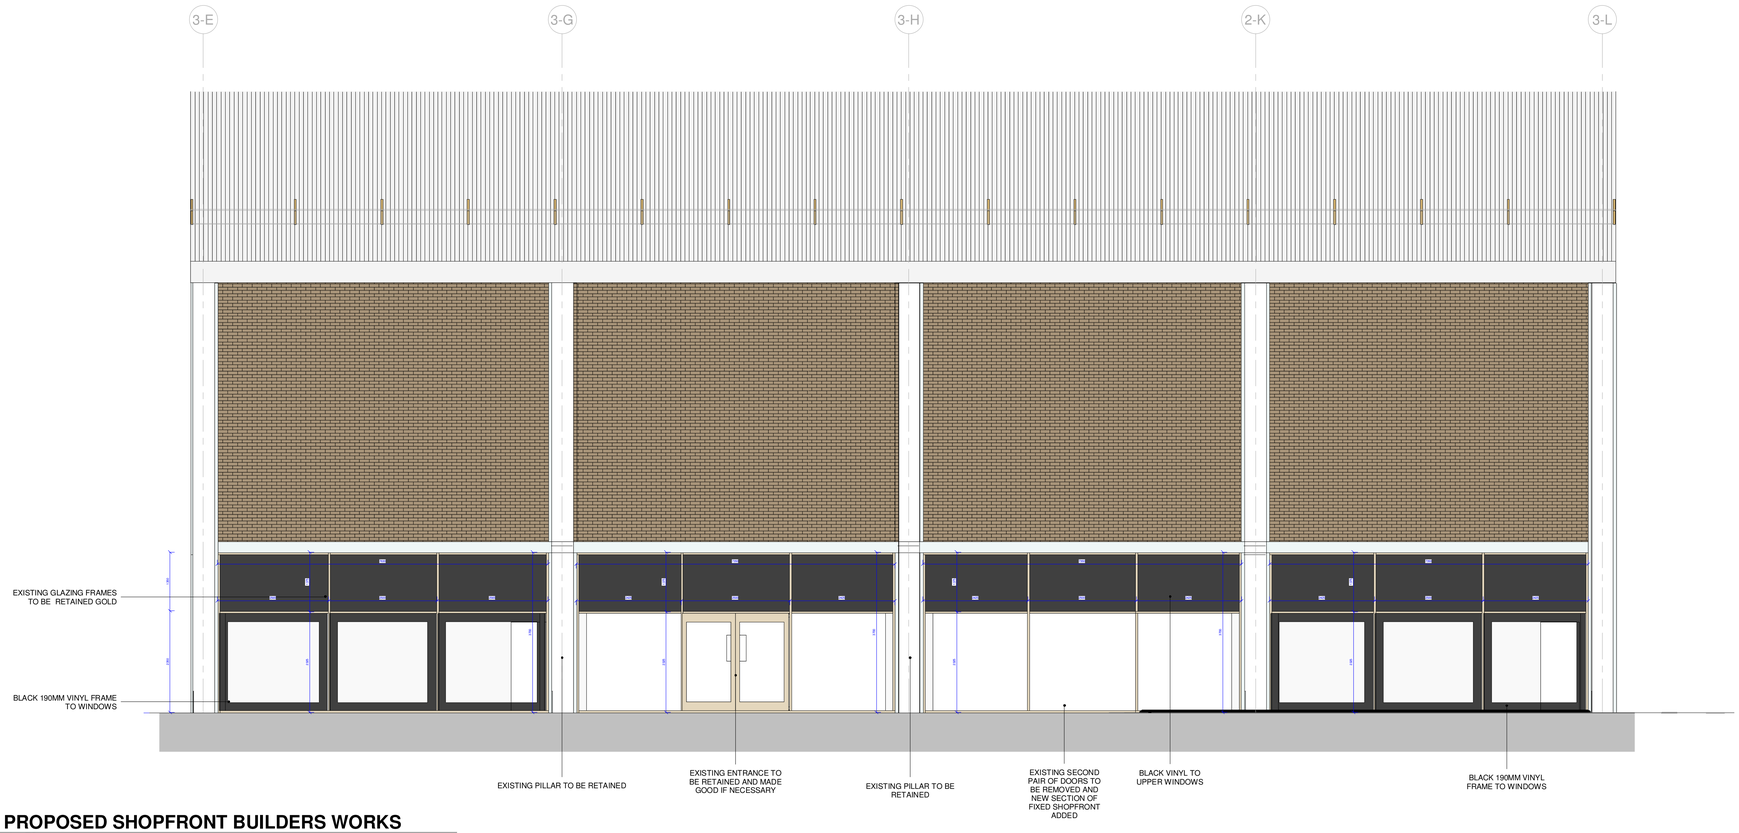

1 PROPOSED SHOPFRONT BUILDERS WORKS

1 : 50

0 5 10

METRIC(1:100)

REV	DESCRIPTION	DATE	BY
C	Updated to 'AS BUILT'	12.10.22	SF
B	Updated as per planning officer review	01.09.22	SF
A	Updated shopfront as per PM instruction	06.07.22	SF

REVISIONS

CLIENT
Frasers Group

PROJECT
UNIT MSU4
THE GLASS WORKS , BARNSLEY

DRAWING TITLE
PROPOSED SHOPFRONT BUILDING WORKS

DRAWN BY	SF	DATE	05/25/22
CHECKED BY	DR	SCALE	1 : 50 @ A0
DRAWING NO	CPS 20 122 PL 105 C		

cube.
Project Management | Building Surveyors
Heritage Consultants | Design Services
502 Birchwood One | Dewhurst Road | Warrington | WA3 7GB
t: 01925 831 710 | f: 01925 839 129
e: dlang@cubepsl.co.uk | w: www.cubepsl.co.uk