
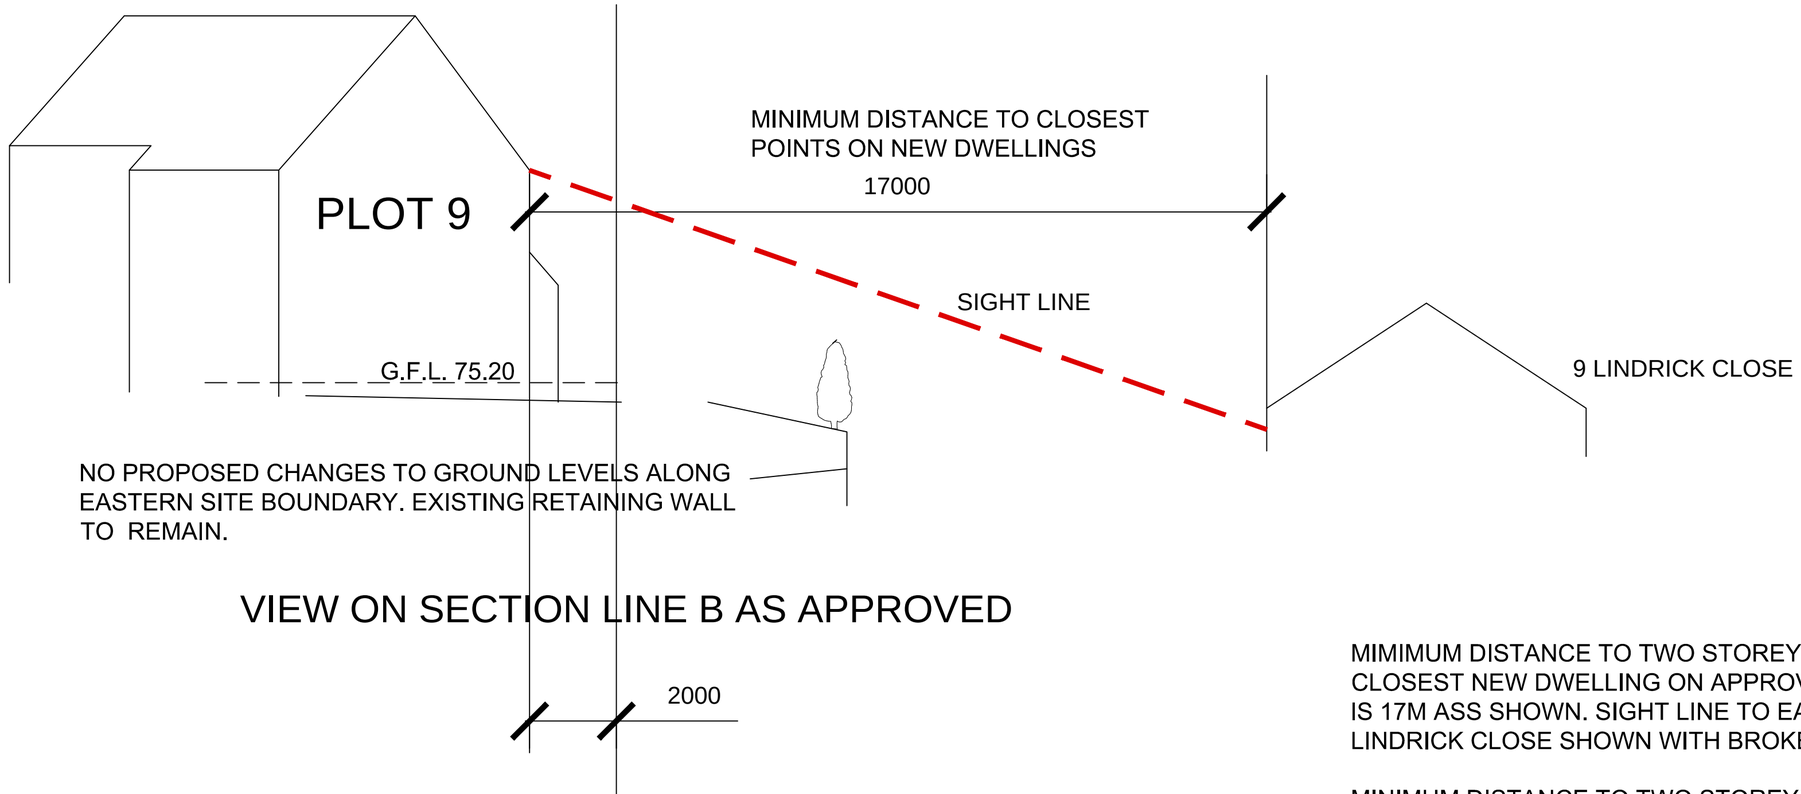


VIEW ON SECTION LINE B AS APPROVED

MIMIMUM DISTANCE TO TWO STOREY PART OF CLOSEST NEW DWELLING ON APPROVAL REF 2013/1181 IS 17M ASS SHOWN. SIGHT LINE TO EAVES FROM 9 LINDRICK CLOSE SHOWN WITH BROKEN RED LINE

MINIMUM DISTANCE TO TWO STOREY PART OF NEAREST DWELLING ON PROPOSED SCHEME IS 15M. TO REDUCE IMPACT OF THE NEW DWELLING OF SIGHT LINE FROM 9 LINDRICK CLOSE THE FLOOR LEVEL OF THE PROPOSED DWELLING HAS BEEN LOWERED AS SHOWN

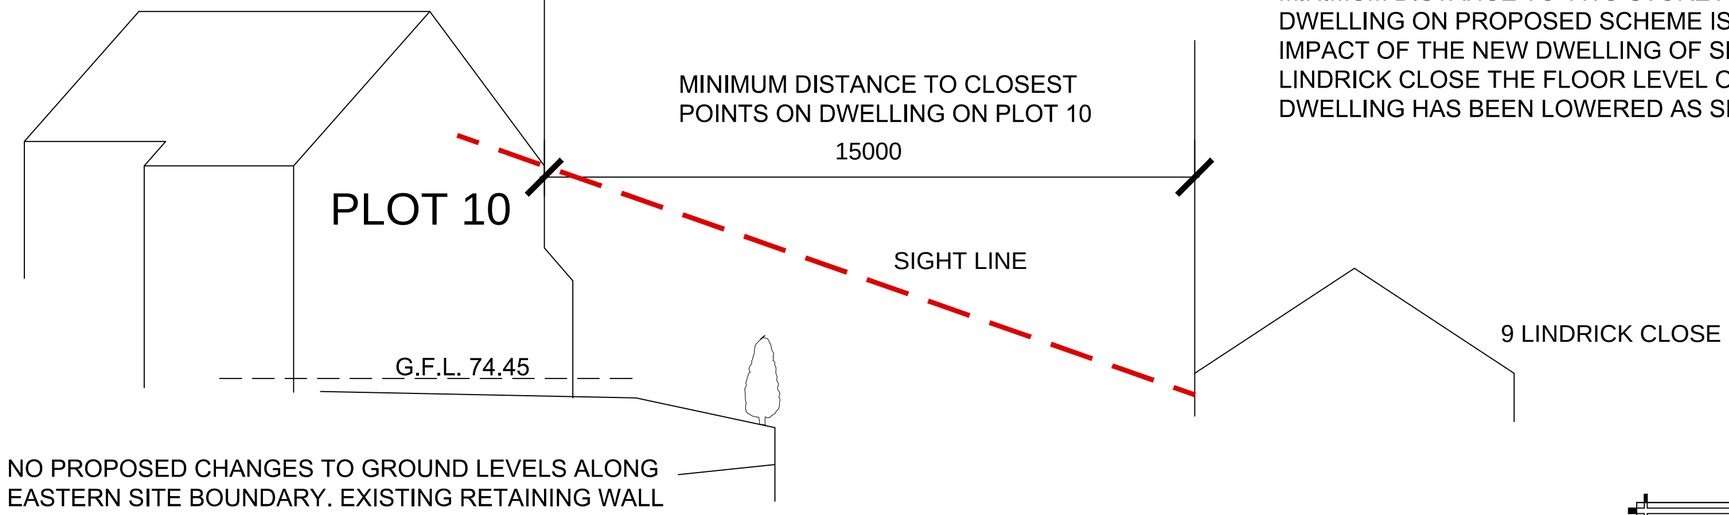

VIEW ON SECTION LINE B AS PROPOSED

White Agus PARTNERSHIP
ARCHITECTURAL SERVICES AND SURVEYORS
8 MORSTON BUSINESS PARK,
WHALEY ROAD, BARUGH GREEN,
BARNSLEY.
S75 1HQ
Phone: 01226 208482
Fax: 01226 283030
Email: info@whiteaguspartnership.co.uk
Web: www.whiteaguspartnership.co.uk

Project. RESIDENTIAL DEVELOPMENT ON SITE OF THE DARDS, CUDWORTH BARNSLEY	Client. ATTA DEVELOPMENTS LTD
Drawing Title. SITE SECTION	Date. NOV 2013 / Scale. 1:100 @ A2
	Ref. 13-043 / Dwg. No. 03 / Rev. B

Date	Suffix	Description	Date	Suffix	Description
03-12-13	A	SECTION B REVISED			
15-01-14	B	SECTION B REVISED			