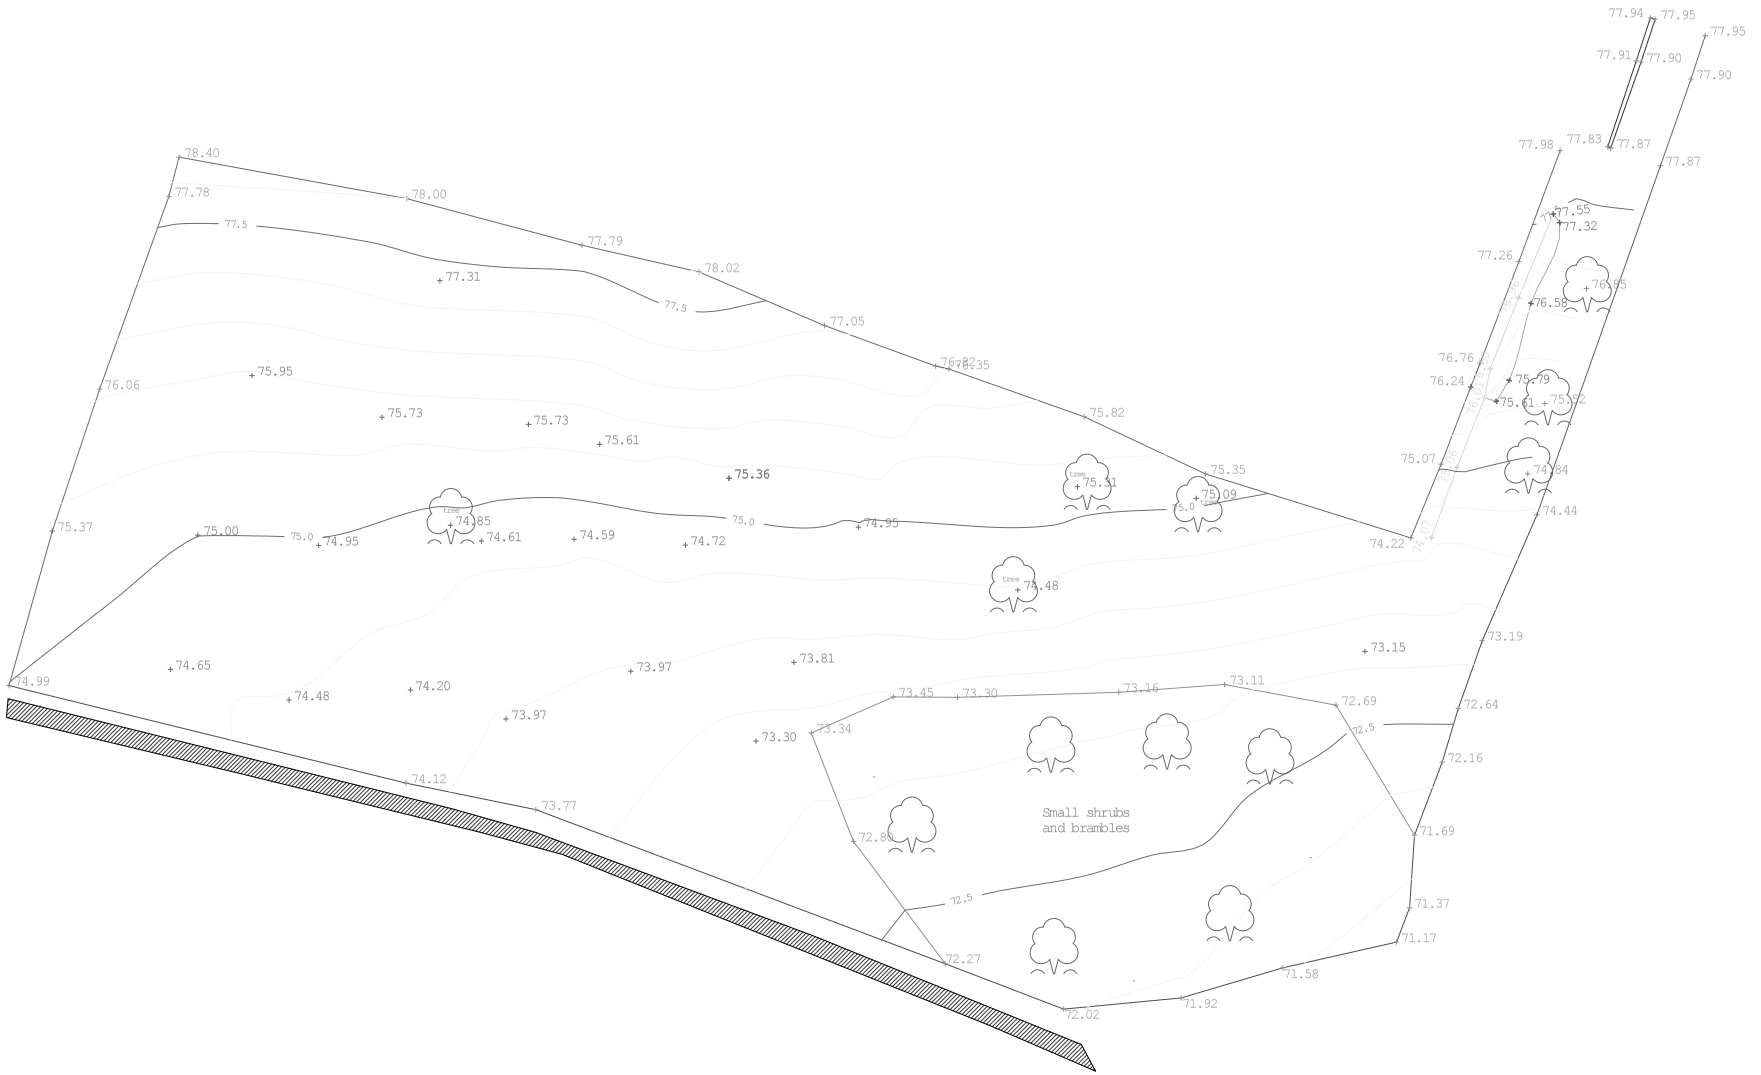


Key to symbols

Reference drawings

Rev	Date	Drawn	Description	Ch'k'd	App'd
AB			As Built Issue		

Client

Title

Knowles Street
Topographical Survey
Land Survey

Designed			Eng.Chk.		
Drawn	c.kipling	ck	Coordination		
Dwg.Chk.			Approved		
Scale at A1		Project RB001			Status
		CAD file			
Drawing No	Knowless Street Topo 001				Rev