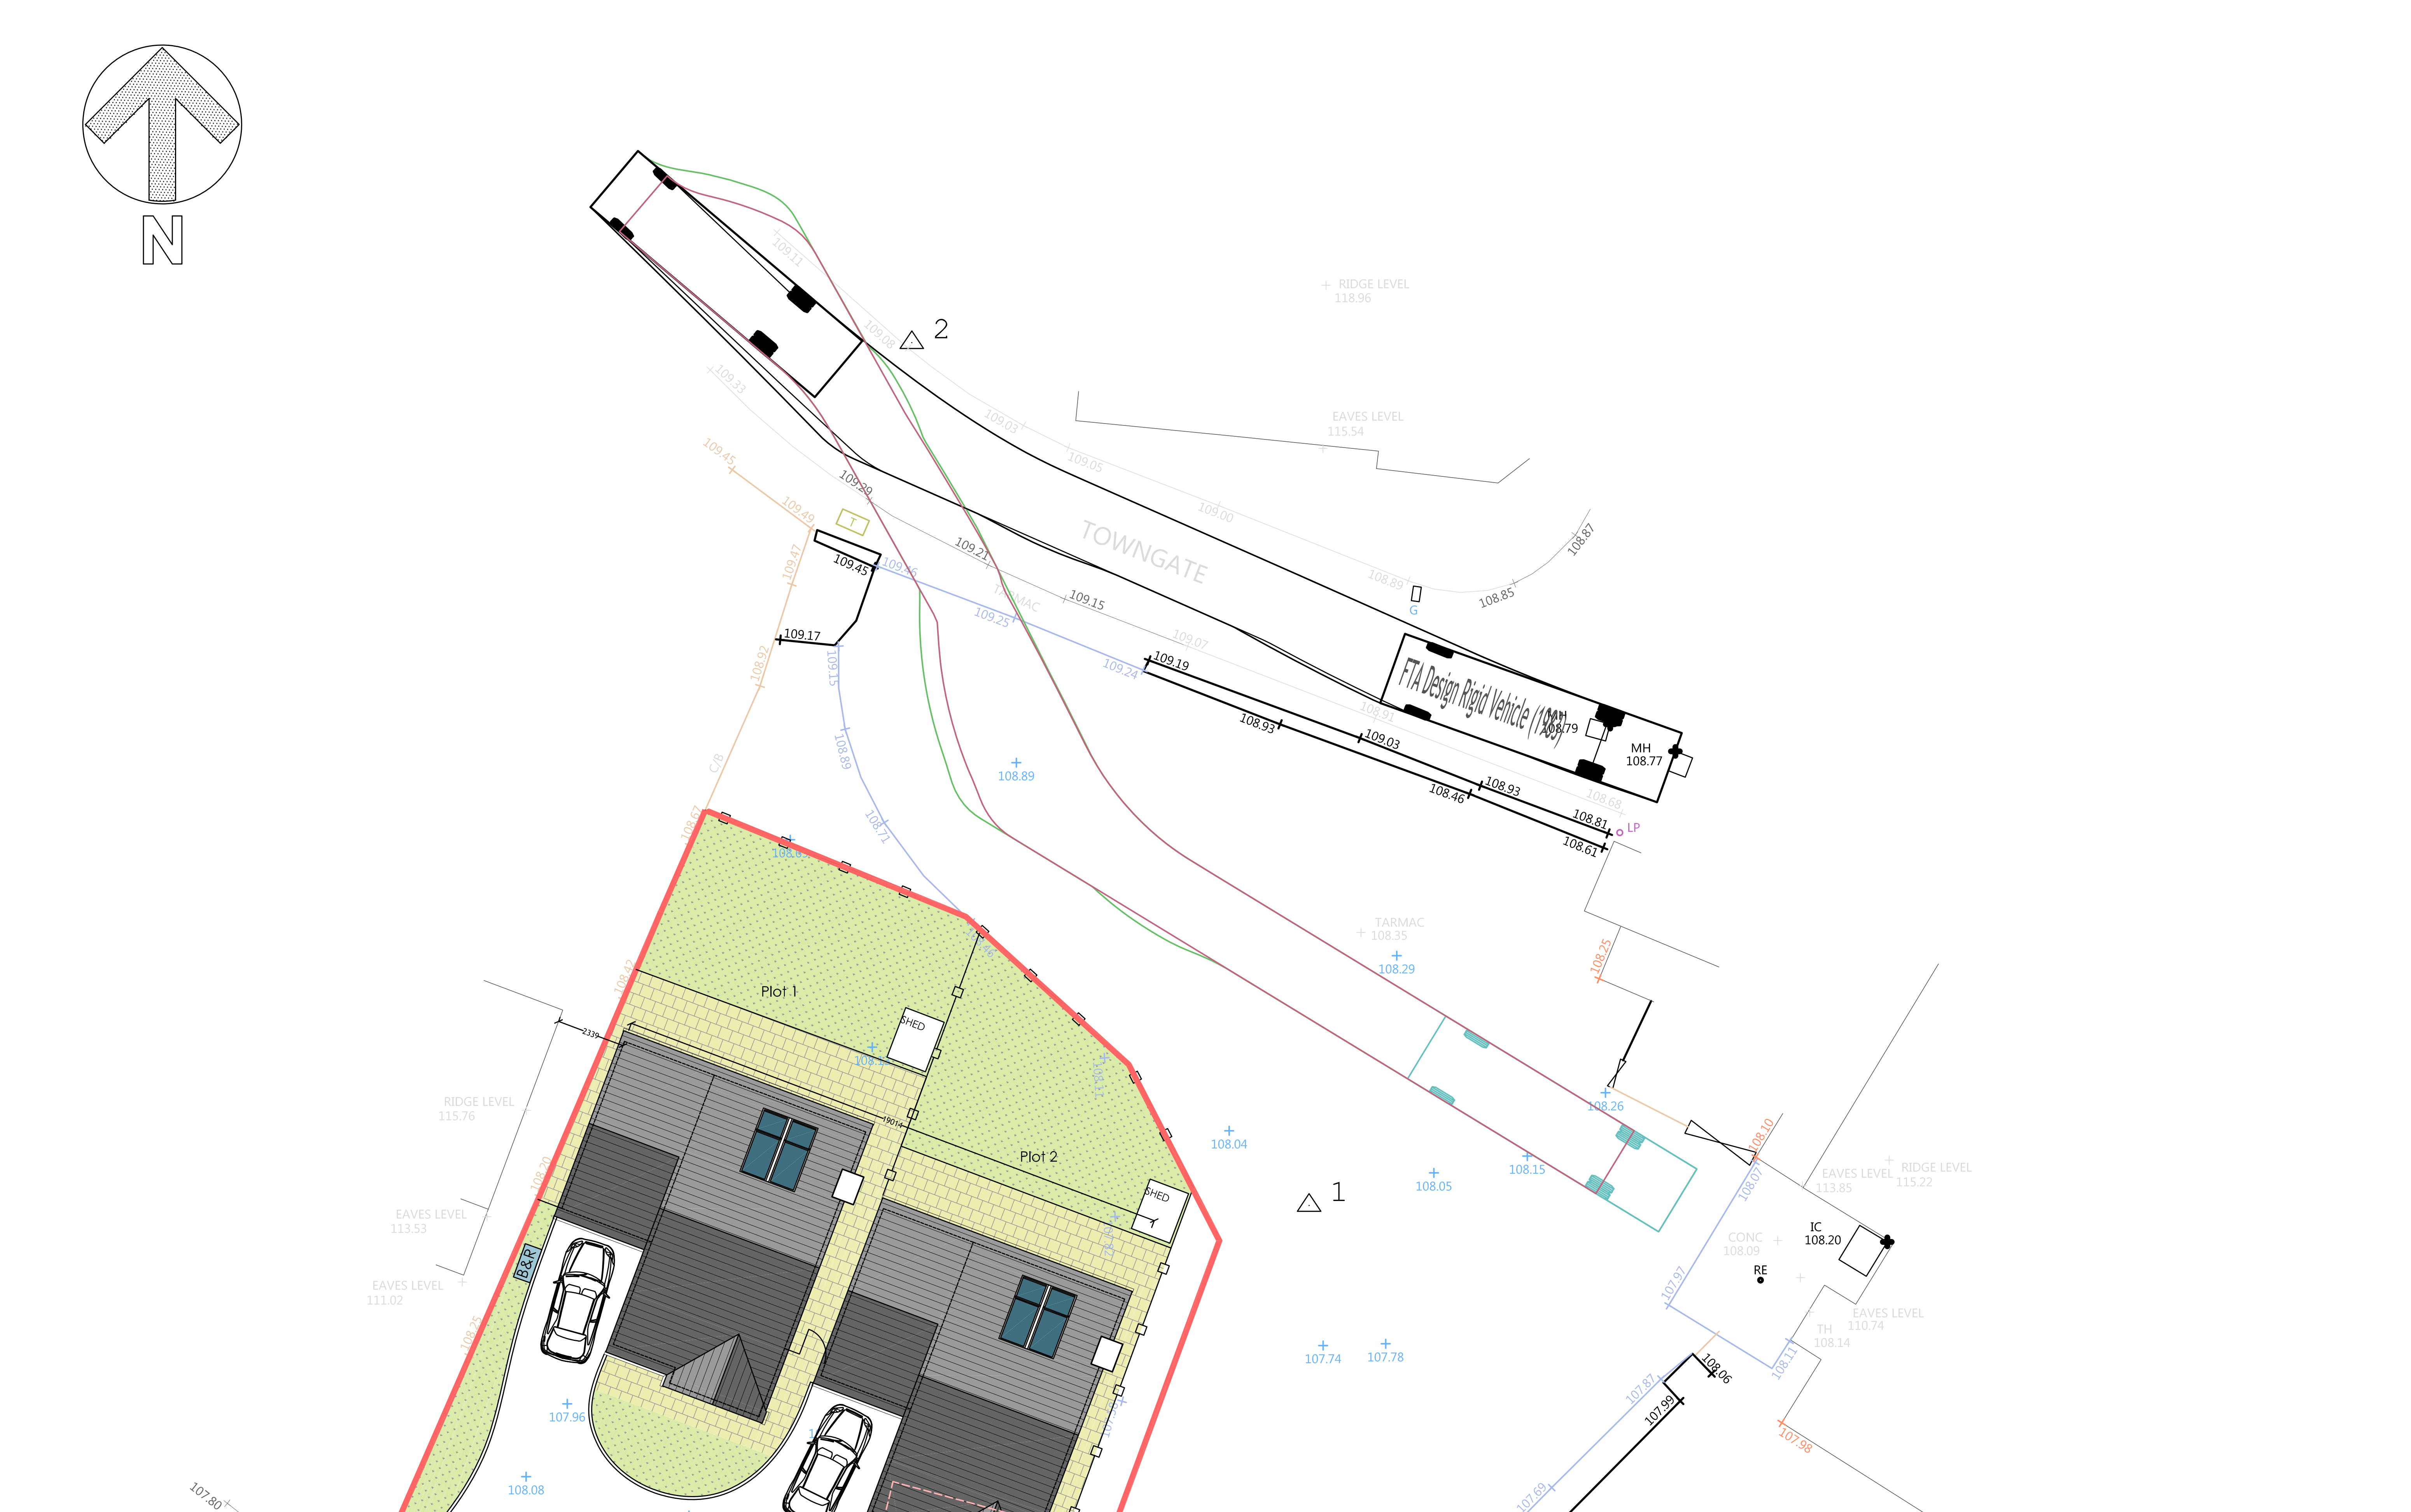

NOTES:

MCD Construction Consultancy take no responsibility for any dimensions obtained by scaling from this drawing. If no dimension is shown the recipient must ascertain the dimension specifically from the Contract Administrator or by site measurement. Supplying this drawing in digital form is solely for convenience and no reliance may be placed on digital data. All data must be checked against hard copy. Dimensions must be checked on site. Any discrepancies must be reported to the Contract Administrator immediately. This drawing is copyright of MCD Construction Consultancy.

Client: Punch Taverns PLC

Pr	Preliminary		C	Contract
F	Feasabilty		Cn	Construction
P	Planning	■	As	As Built
T	Tender		Other	

Project: The Kings Head, Mapplewell

Title: Exiting delivery access

Dwg Scale: 0 2m 4m Scale 1:200 A3

Drawing No: 343-10

Revision: •

Shady Oak, Marple Rd. Stockport SK2 5HF
07795 388610
07983 347252
www.mcdcc.co.uk
info@mcdcc.co.uk
MCD CONSTRUCTION CONSULTANCY