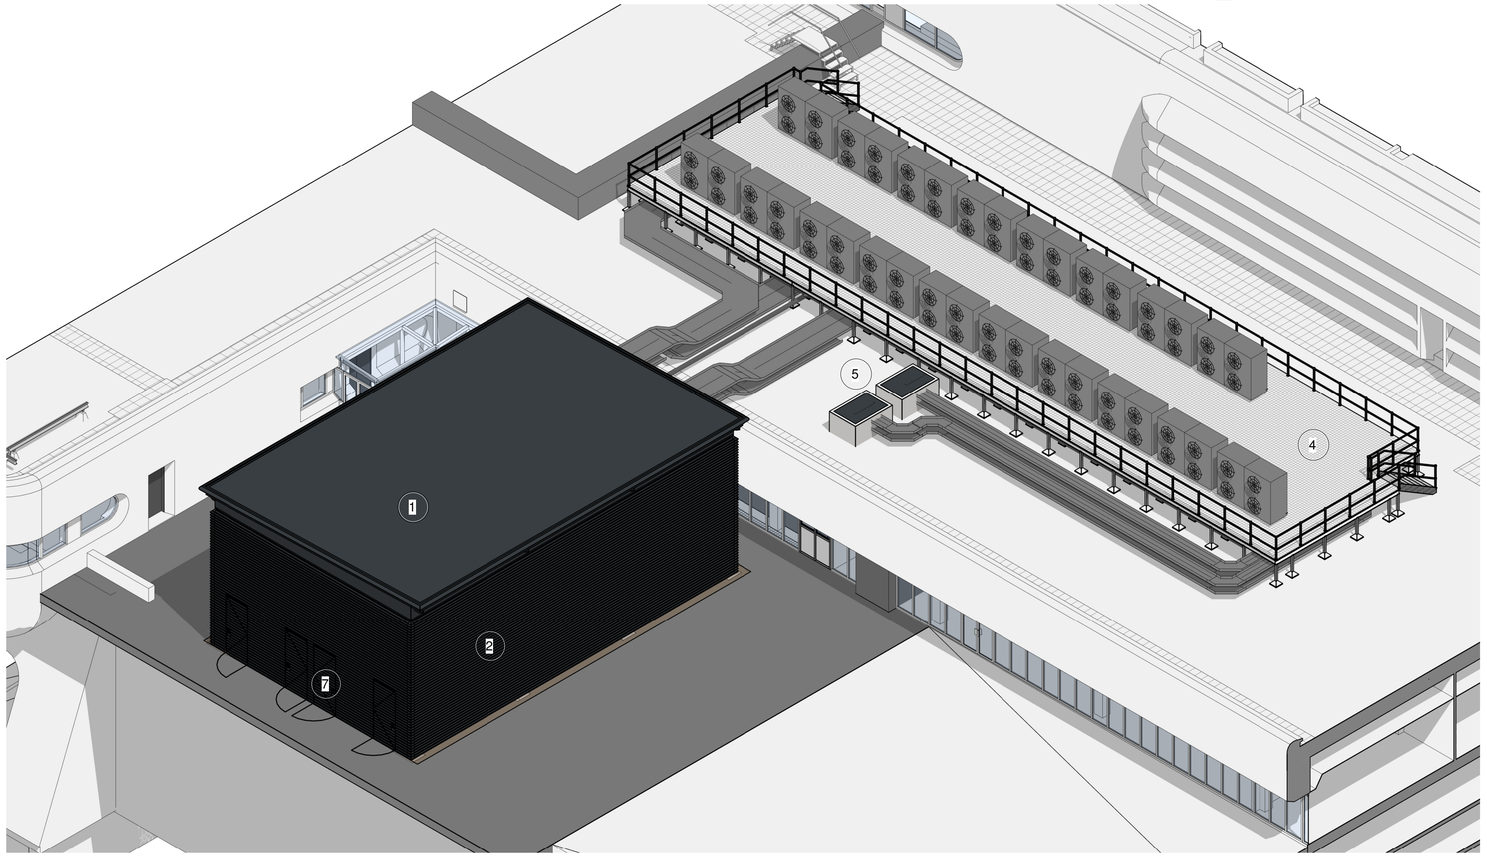

PENTHOUSE LOUVER NOTES (PROPOSED)

1. Kingspan QuadCore Low-pitch roof insulated sandwich panel. Roof pitch 1.5° or more after deflection. 115mm Core Thickness AQUAsafe55 internal liner sheet coating 15-25% recycled content. Thermal transmittance 0.15 W/m²K Density 38 Kg/m³ ±10%.
2. Weather Louvres Renson Linus Type L050W.
3. Single Powder coated RWP in NW corner connect to existing surface drainage system.
4. Grating (Spec. TBC) on bigfoot support system, subject to confirmation by Structural Engineer. Fan units as per MEP Engineer's design.
5. 2 Number Nicholson Rooftox M Modular cabinet with kerb to suit roof build-up. Insulated Modular cabinet in PPC Aluminium to suit roof opening 200x1300mm.
6. Attenuator units to MEP designer / manufacturer's detailed design.
7. Louvre doors with solid blanking panel behind and parliament hinges; subject to receipt of manufacturer's detailed design information.

3D_AXIS_PENTHOUSE PROPOSED

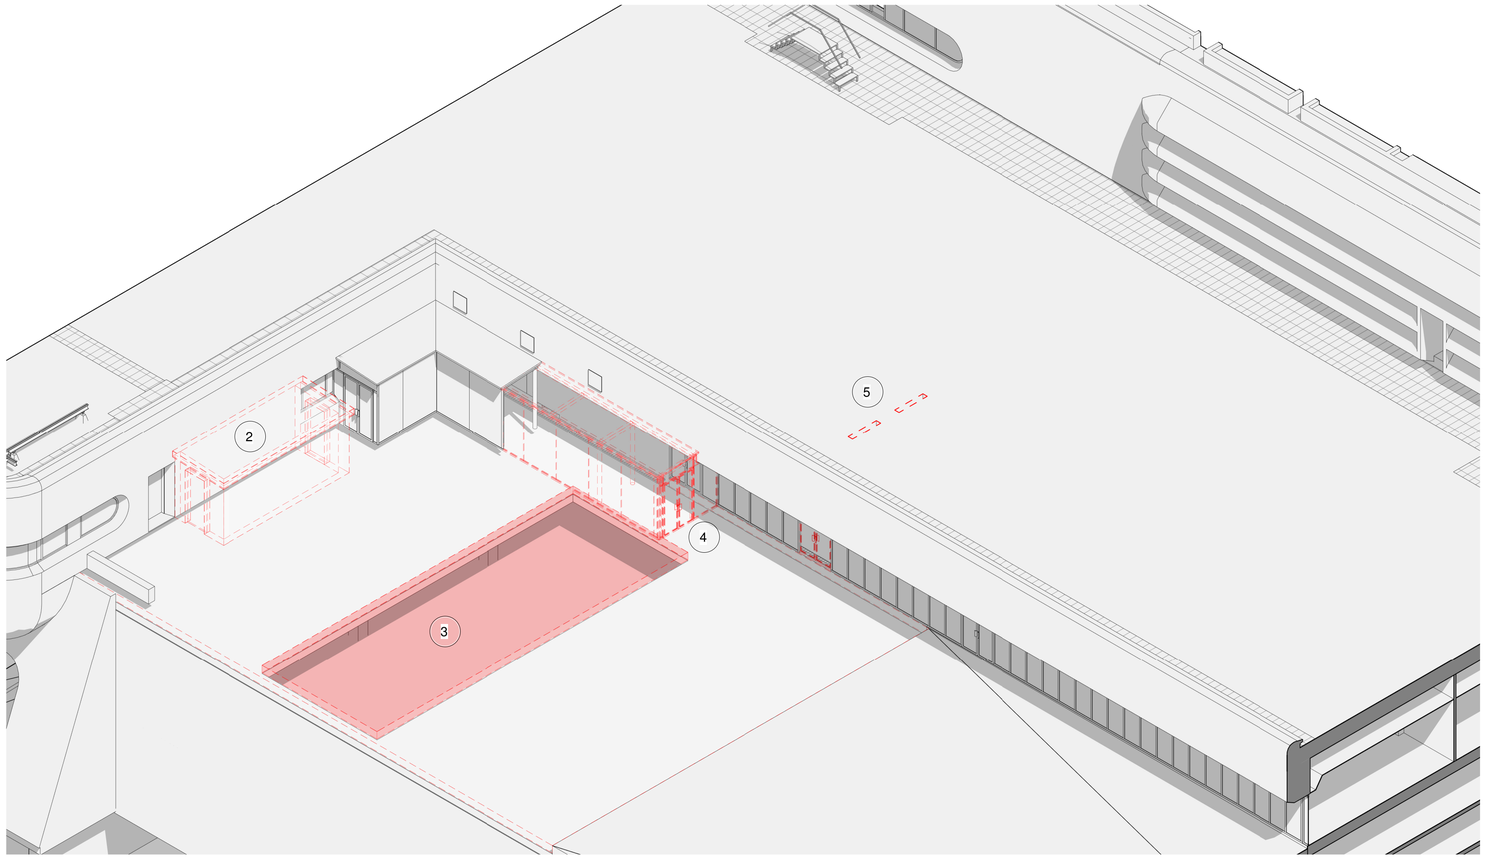

PENTHOUSE LOUVER NOTES (EXISTING)

1. Building alterations / demolition indicated with dashed red line.
2. Existing store to be retained until further review at the end of the project.
3. Opening to be formed in existing slab.
4. Existing glazed door to be re-used; subject to site survey and inspection.
5. Form 2 No 1300x 200mm openings through roof to New switchrooms below.

3D_AXIS_PENTHOUSE EXISTING

RESIDUAL RISK

Wherever possible unnecessary risk is designed out of these proposals. Where residual risk remains this is assessed and identified on the relevant drawings with this symbol. Refer to the note and the relevant measures in the Health & Safety documentation

NOTES

AXIS Design based on as-received survey information. MEP design as per MEP Engineer's detailed design drawings / information. Structural Design as per Structural Engineer's detailed design drawings / information. To be read in conjunction with all relevant consultant's drawings / information.

	Reason for Issue:	By:	Date:

Revision Schedule
File Path: C:\Revit Local\27708-AXIS-XX-XX-M3-A_Cameron.Shackley.rvt

AXIS architecture
Talbot Chambers 2-6 North Church Street Sheffield S1 2DH
Tel: 01142490944 www.axis-architecture.com

SYGDC Tankersley

HSBC Global Services (UK) Ltd

PENTHOUSE-B 3D

EXISTING AND PROPOSED

Scale at A1 [594mm x 841mm]	Date	Drawn By	Revision
As indicated	JUN 2024	AXIS	
Project Number	Drawing Number		
	27708-A(05)03		

Dimensions in millimetres unless stated otherwise | DO NOT SCALE off drawing
Dimensions govern| Verify prior to construction |Notify any discrepancies

© COPYRIGHT EXISTS ON ALL DESIGNS AND INFORMATION SHOWN