


Notes

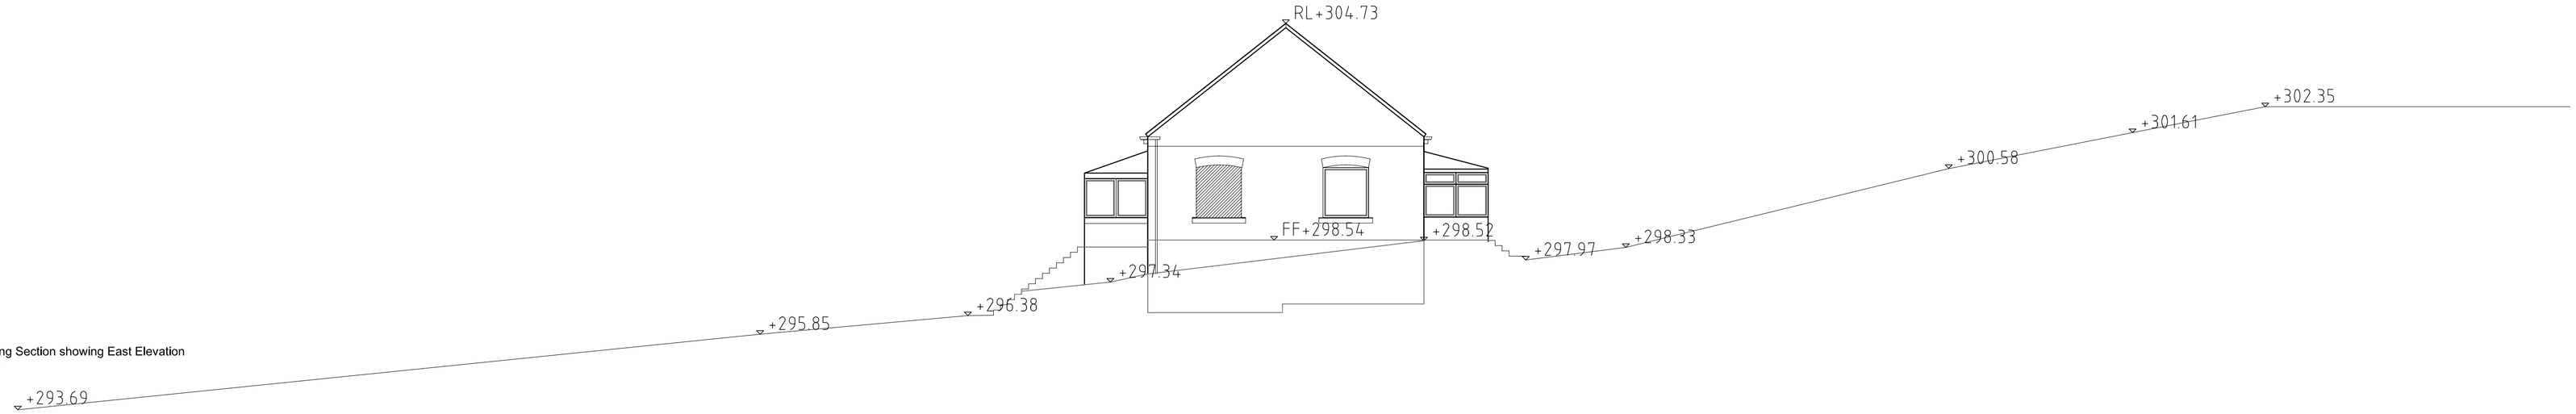


Existing Section showing East Elevation
1:100

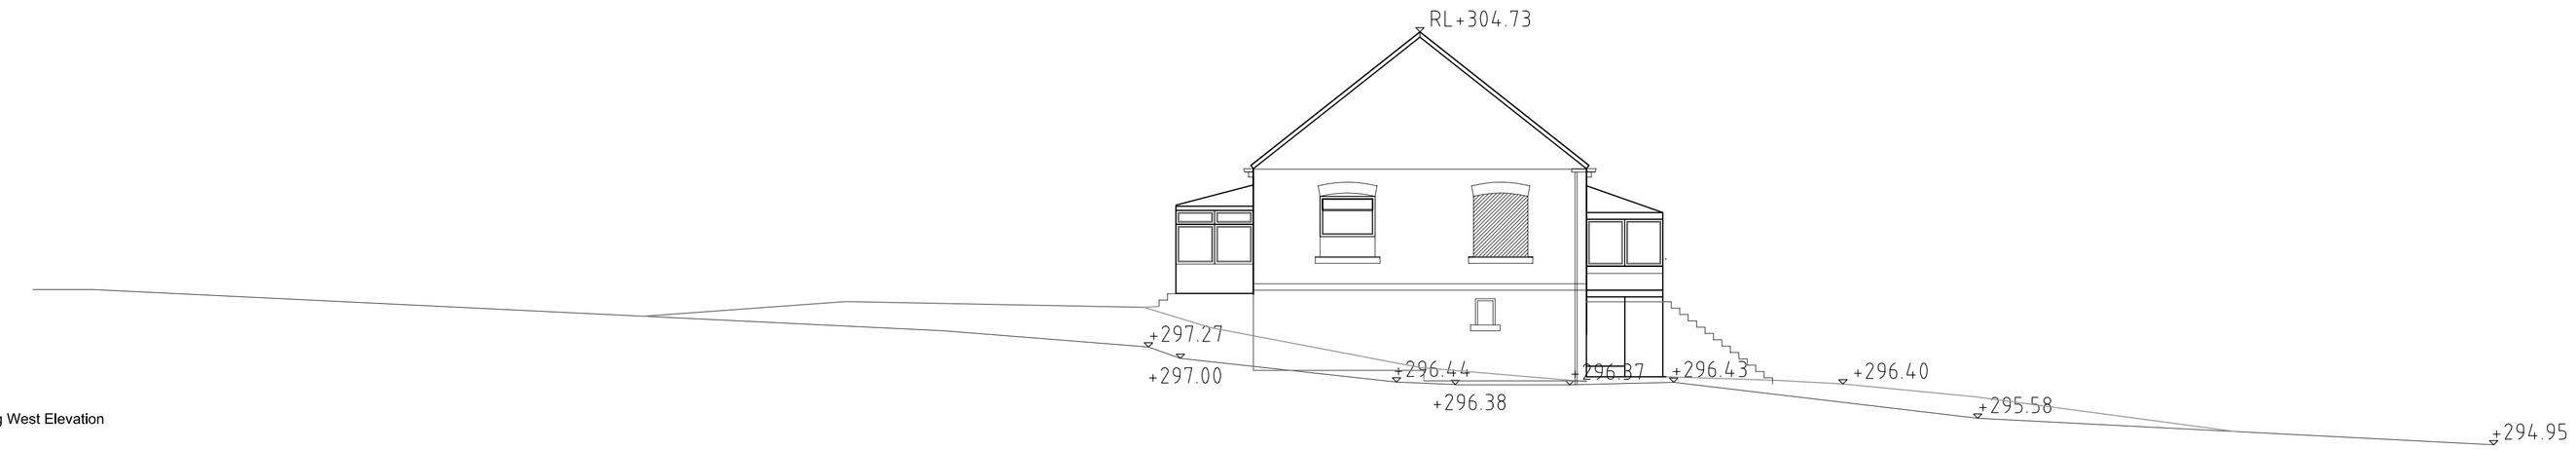

Existing Section showing West Elevation
1:100

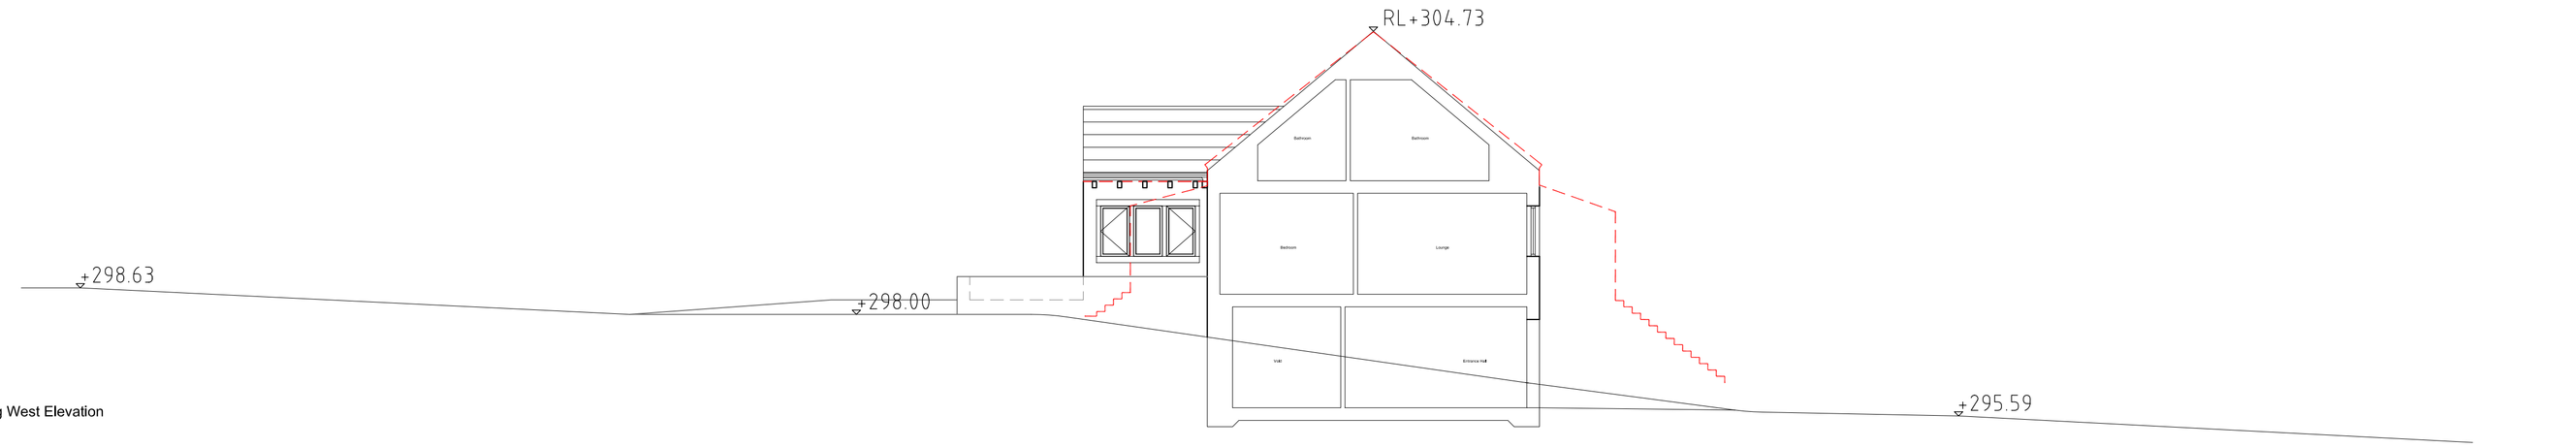

Proposed Section showing West Elevation
1:100

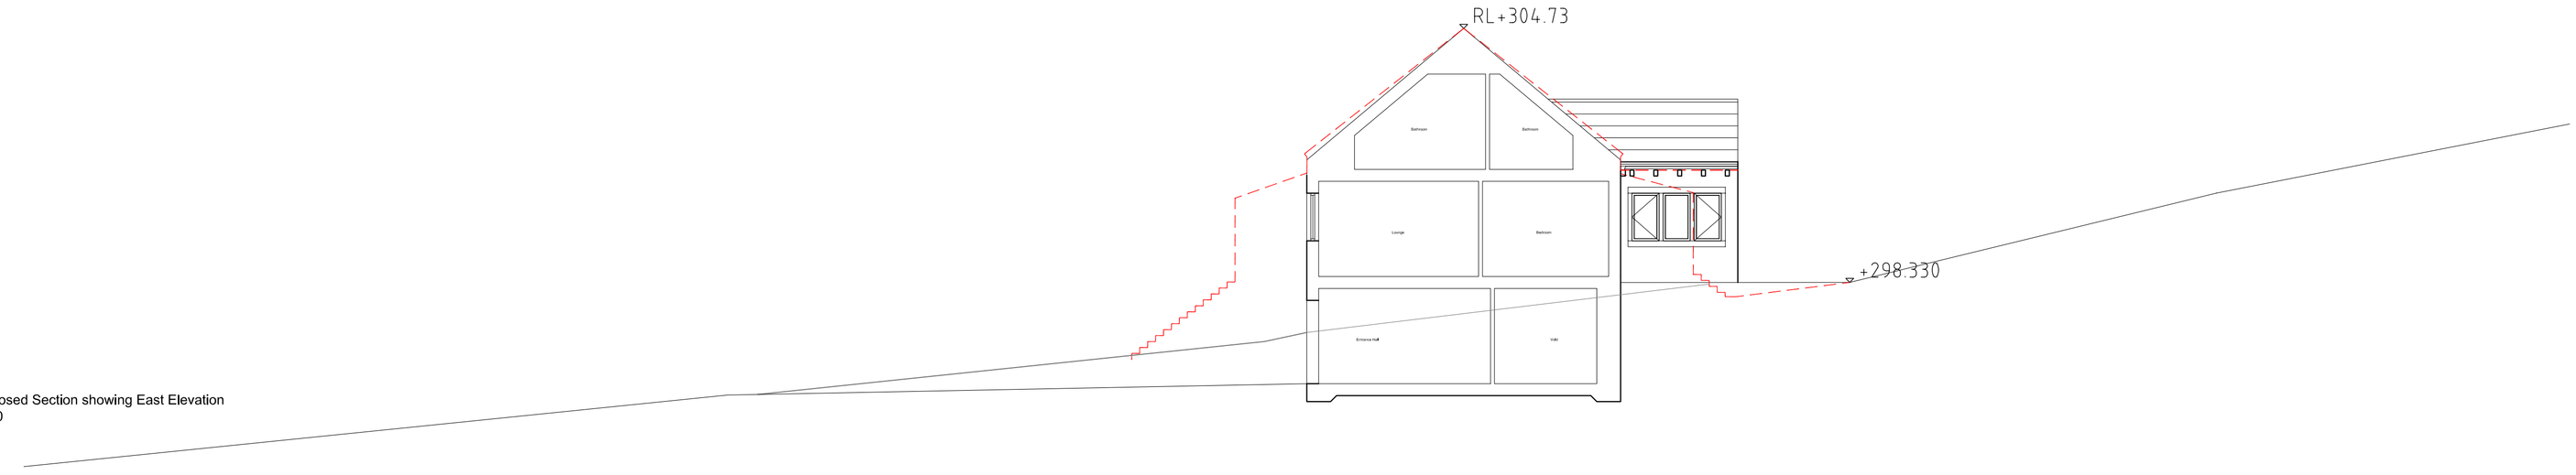

Proposed Section showing East Elevation
1:100

Outline of Original House shown in red for comparison purposes

Revision	Description	By	Date

CAD Info: G:\ACAD\ARCH

Essence Architecture Ltd

Client

Mr & Mrs Goldthorpe

Project

Villa Providence
Demolition and rebuild of Dwelling

Drawing Title

Site Sections
Existing & Proposed

A1	Scale 1:100	Status Planning
Drawn JSH	Checked AVR	Date 7 1 2016
Project No. 2015-39	Drawing No. PR03	Revision

Head Office: 14 Spinners Way
Lower Hopton
Mirfield
West Yorkshire
WF14 8PU

Tel: 01924 490078
Fax: 01924 490095
Email: mark@ronandevelopments.com
Web Site: www.ronandevelopments.com