




COFFEE CAPACITY INFORMATION					
4th Hour Peak			Max Peak		
Current Machines	Units Sold	Capacity %	Units Sold	Capacity %	Barista Machines
4	168	51.90%	173	53.40%	3

Note: This drawing is the property of Four-by-Two Consultants Limited. Copyright is reserved by them and the drawing is issued on the condition that it is not copied, reproduced or disclosed to any unauthorised person, wholly or in part, without the written consent of Four-by-Two Consultants Limited. Four-by-Two Consultants Limited will not accept responsibility for errors made by others in scaling from this drawing. All construction information should be taken from figured dimensions only.


Revision	Date
----------	------

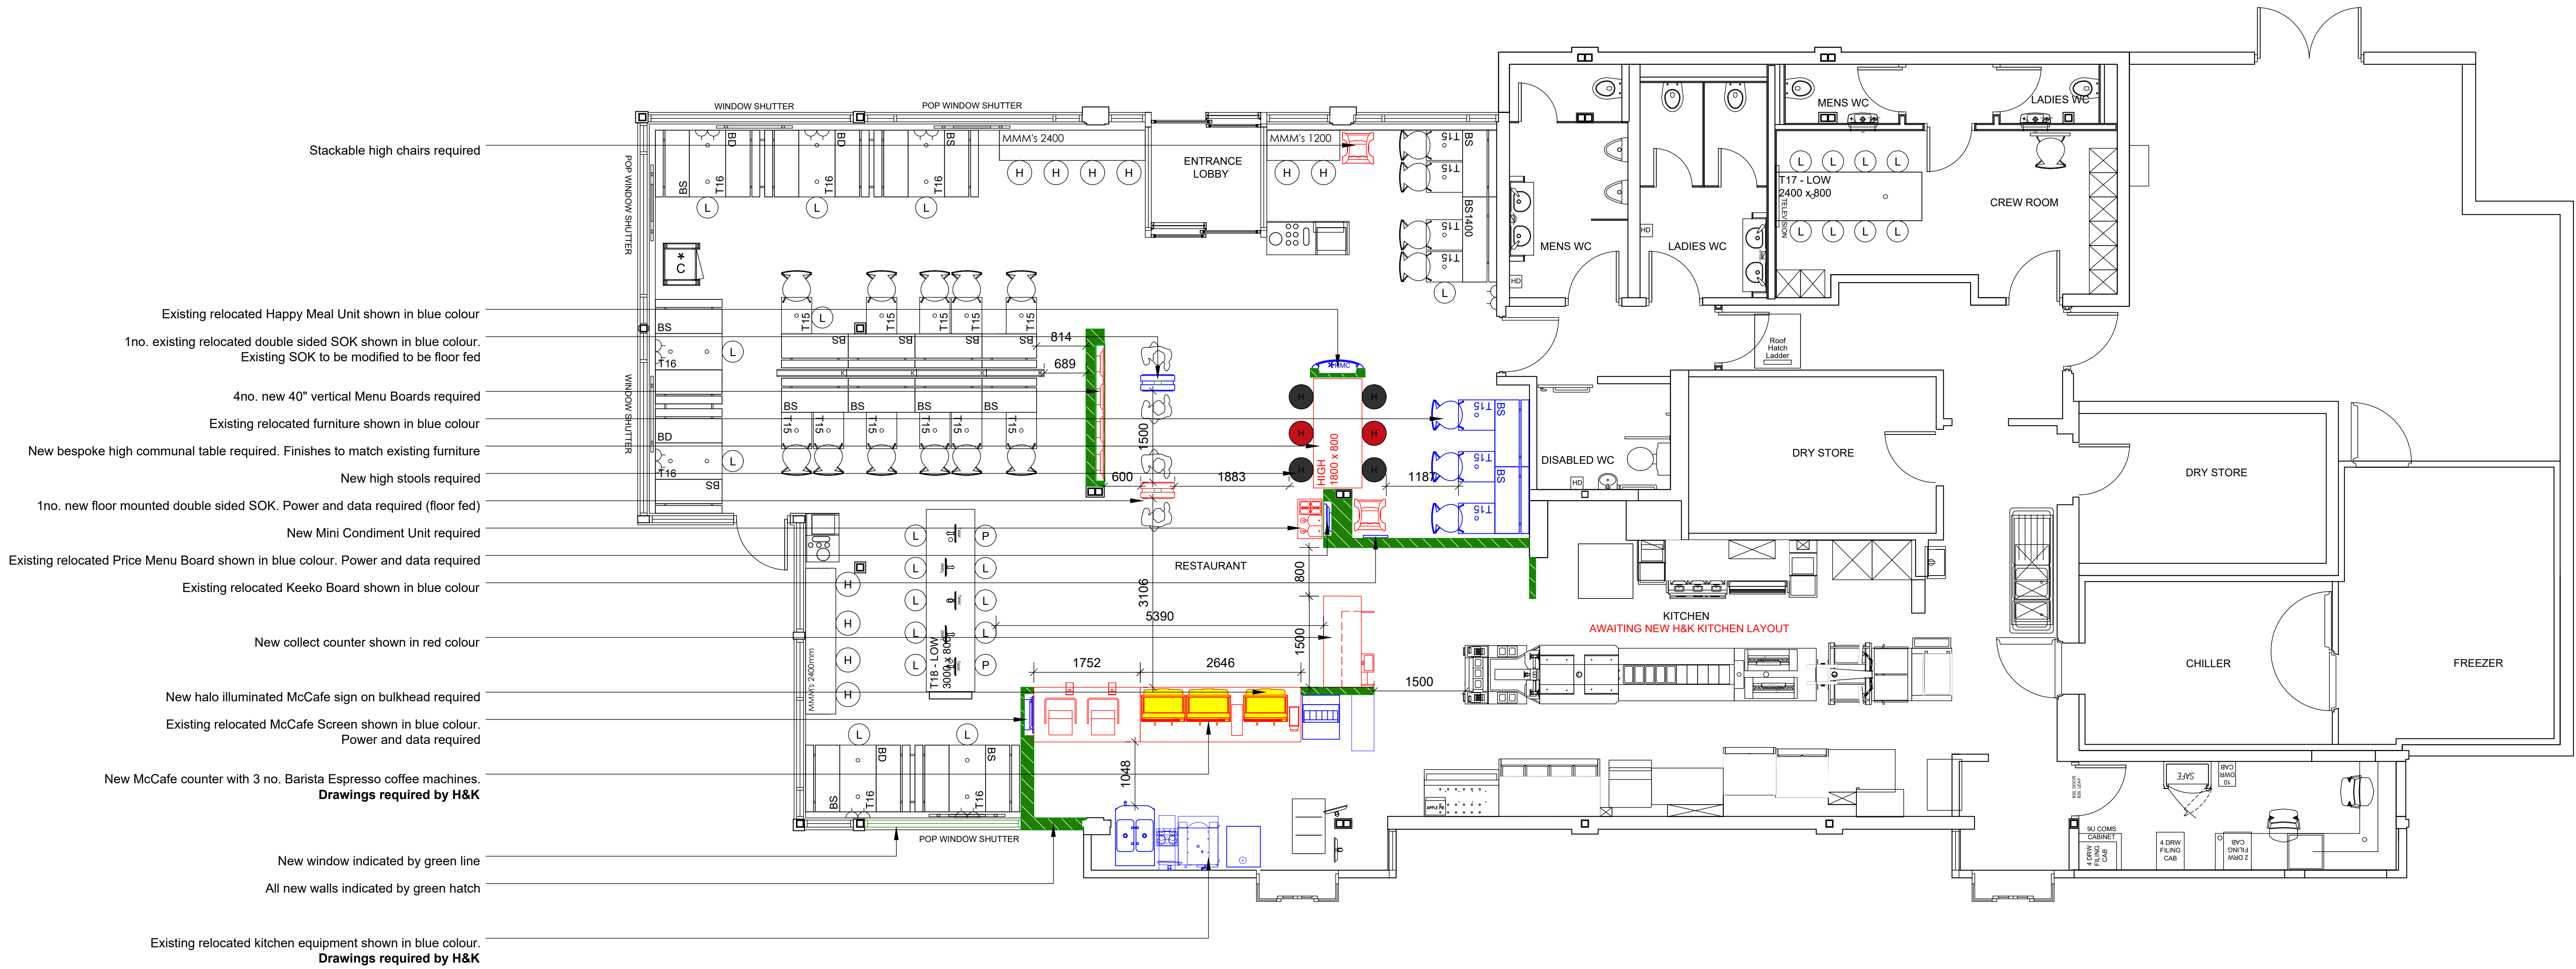

- Stackable high chairs required
- Existing relocated Happy Meal Unit shown in blue colour
- 1no. existing relocated double sided SOK shown in blue colour. Existing SOK to be modified to be floor fed
- 4no. new 40" vertical Menu Boards required
- Existing relocated furniture shown in blue colour
- New bespoke high communal table required. Finishes to match existing furniture
- New high stools required
- 1no. new floor mounted double sided SOK. Power and data required (floor fed)
- New Mini Condiment Unit required
- Existing relocated Price Menu Board shown in blue colour. Power and data required
- Existing relocated Keeko Board shown in blue colour
- New collect counter shown in red colour
- New halo illuminated McCafe sign on bulkhead required
- Existing relocated McCafe Screen shown in blue colour. Power and data required
- New McCafe counter with 3 no. Barista Espresso coffee machines. Drawings required by H&K
- New window indicated by green line
- All new walls indicated by green hatch
- Existing relocated kitchen equipment shown in blue colour. Drawings required by H&K

01 | PROPOSED GA

Scale: 1/50

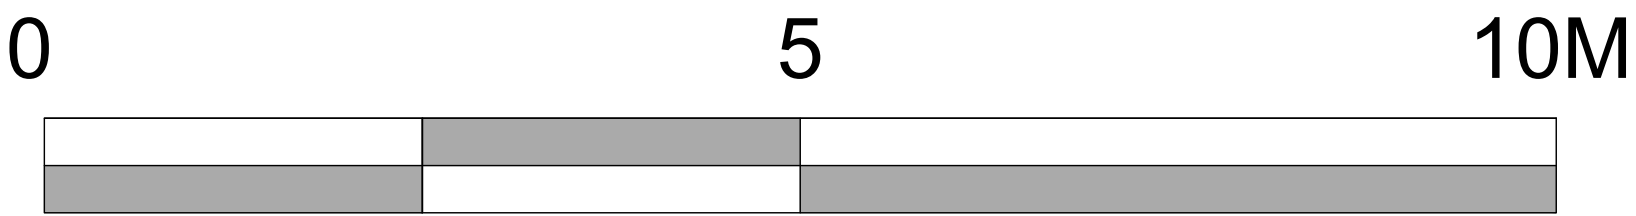

ISSUED FOR BARISTA WORKING GROUP APPROVAL

AREAS SCHEDULE		
Description	Existing	Proposed
Total Covers	97	99
Queue - Width	3.00 m	see plan
Path - Width	2.88 m	see plan
Approx. Dining Area (M²)	115.68 m²	117.65 m²

SUNDRIES SCHEDULE		
Description	Existing	Proposed
Happy Meal Chair	8	6
Tablets	5	5



Four-by-Two Consultants Limited
De Beauvoir Block 1 Unit 4 |
92-96 De Beauvoir Road
London N1 4EN

T: UK (0)20 7253 9898
E: info@four-by-two.com
www.four-by-two.com

Client
MCDONALD'S
RESTAURANT LTD

Project
TANKERSLEY,
WENTWORTH RETAIL
PARK, BARNESLEY, S75 3AX

Store no.
0584

Existing concept
LIM FOOD

New concept
N/A

Drawing title
PROPOSED GA
OPTION 3

Drawing stage
STAGE 1

Issue date 13.08.18	Drawing number 18041_0584_50.3	Rev -
------------------------	-----------------------------------	----------

Scale 1/50 @A0	Drawn by AT	Checked by BdF
----------------------	----------------	-------------------

© copyright of Four-by-Two Consultants Limited

McCAFE BARISTA TEST - N/A