

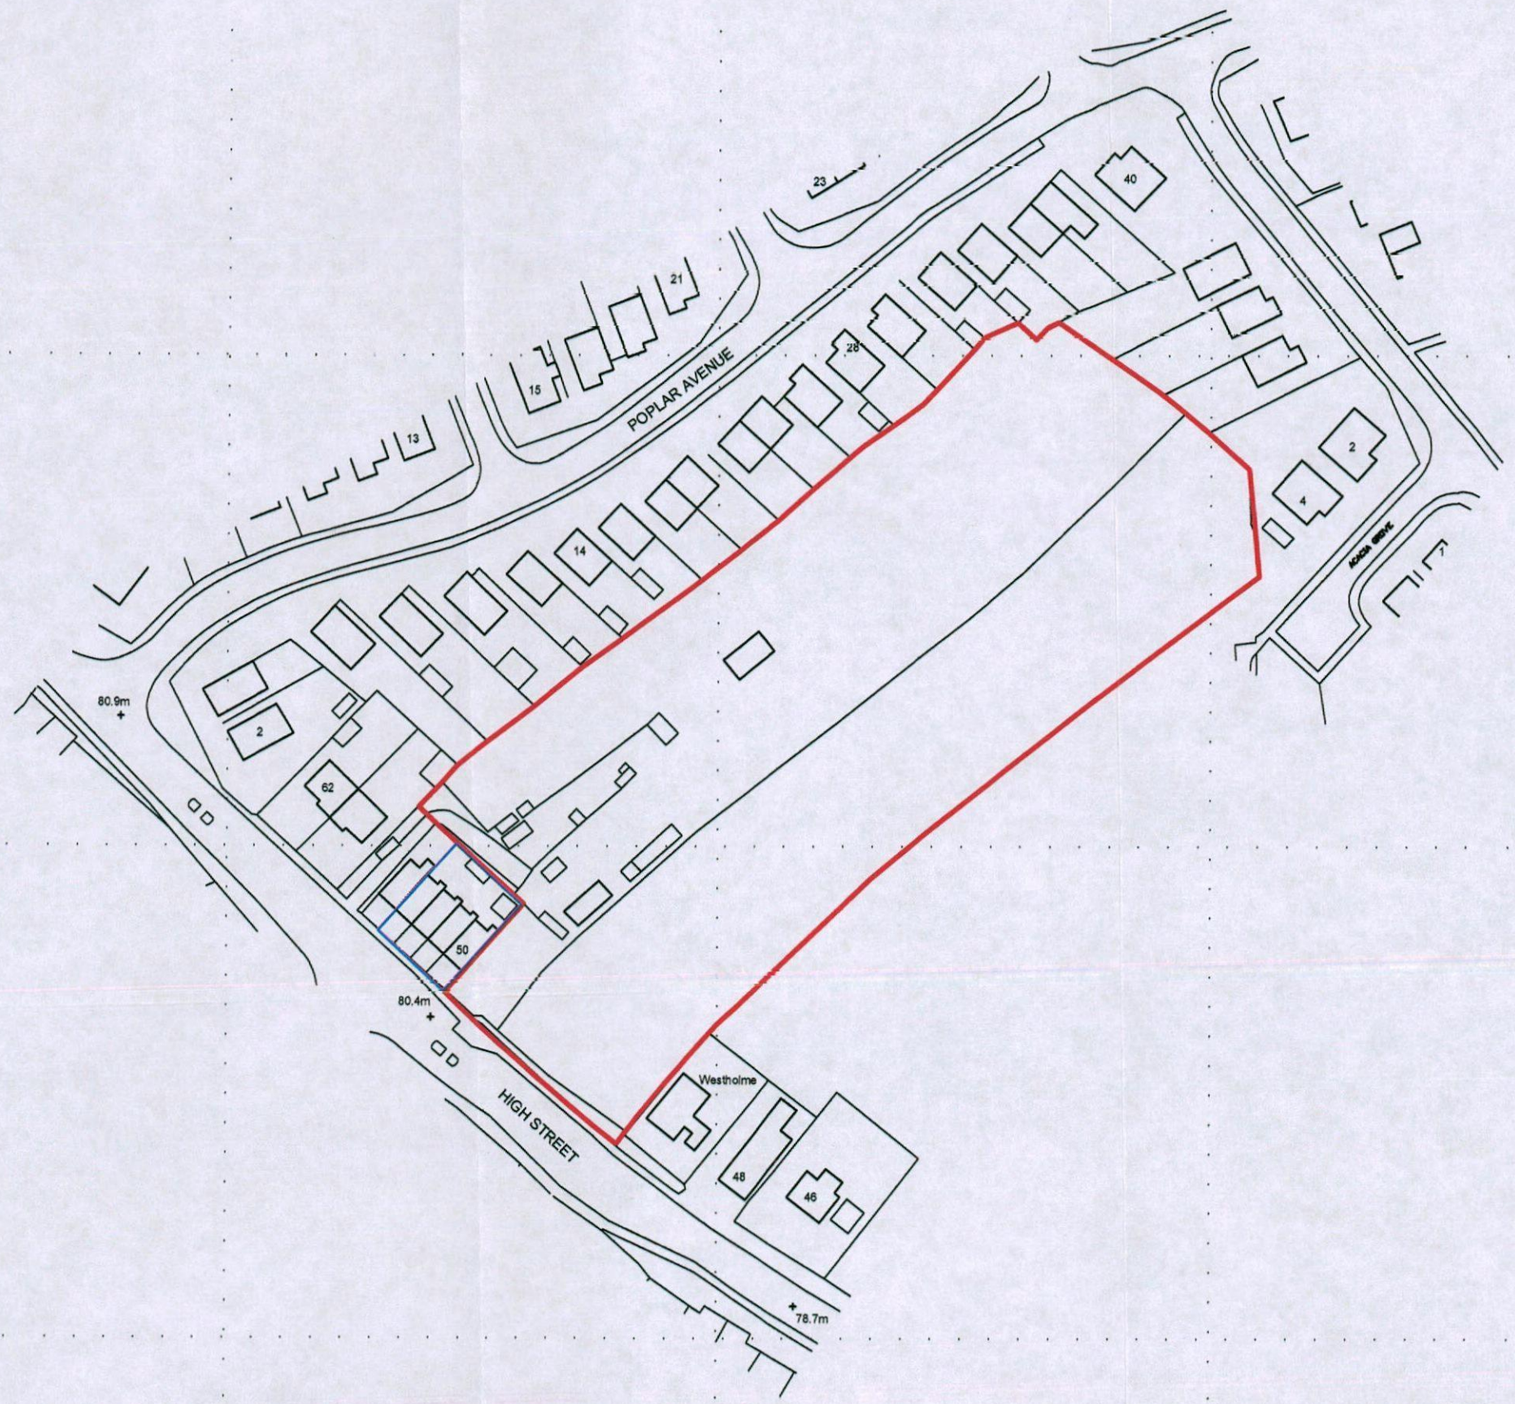


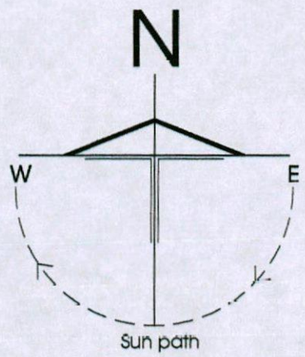

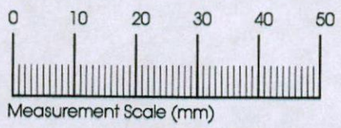

Rev A: Red line boundary amended 22.07.15
Revisions:

Residential Development

at High Street
Shafton
Barnsley

for Oldham Access Services

Location Plan

Farrar Bamforth Associates Ltd.

Chartered Architectural Technologists

51, Trinity Street, Huddersfield HD1 4DN
Tel. (01484) 424008 Fax. (01484) 512305
E-mail : design@farrarbamforth.co.uk
Website : www.farrarbamforth.co.uk

Drawn	DRH
Date	October 2014
Scales	1:1250 @ A3
Drawing No.	13-D95-OS Rev. A