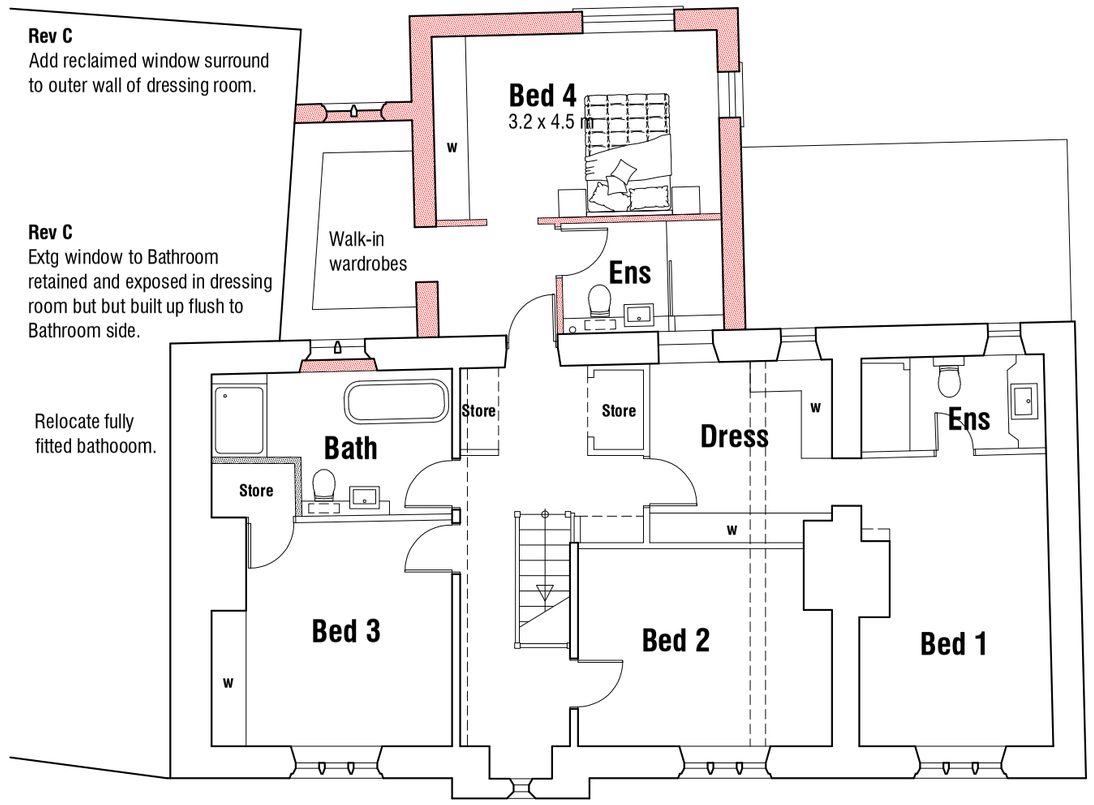

FIRST FLOOR PLAN 1:50

Rear Elevation - East 1:100

Side Elevation - South 1:100

Enclose canopy roof to south with second hand coursed stone walling to match existing set into 100mm return at rear external corner of extg house.

Half round aluminium gutters and circular rainwater pipes with black ppc finish.

NEw windows to be timber with off white paint finish to match existing set into 75mm reveals, sealed with mastic and overpointed with mortar fillet.

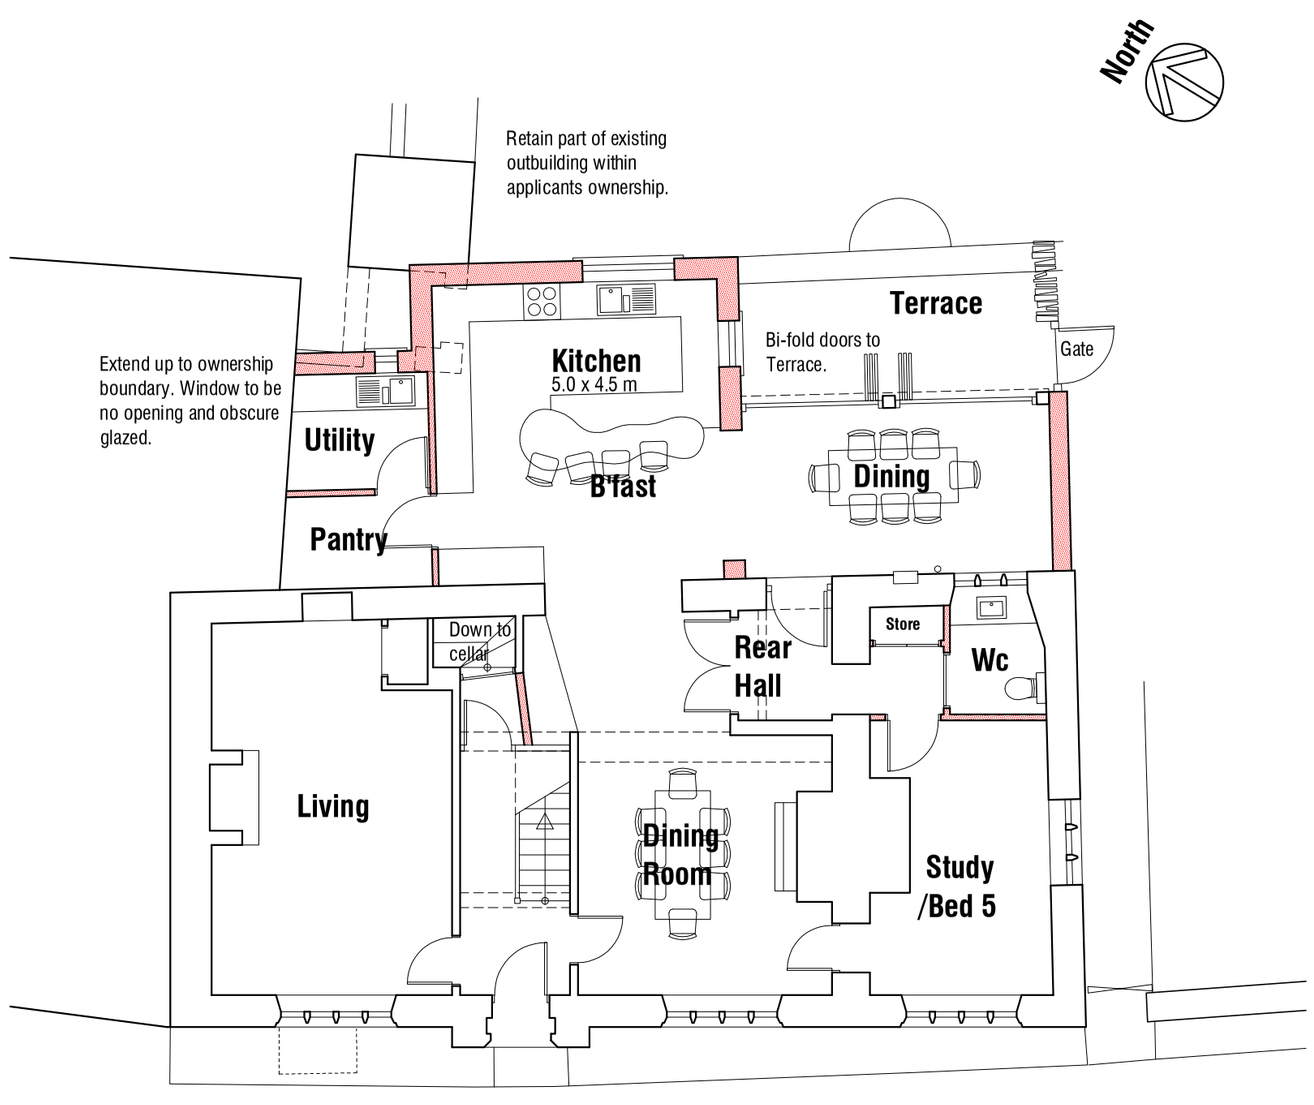

GROUND FLOOR PLAN 1:50

Site Plan 1:200

C 01.02.2019 - Add details of retained bathroom window and add reclaimed window to dressing room.

B 20.12.2018 - Amended red line boundary.

A 06.12.2018 - Amended and updated for Planning Application.

Chantry House
Church Street
Cawthorne
Barnsley

OUTLINE PROPOSALS

PLAN AND ELEVATIONS

mboothdesign
architectural design and building consultants

Fairfield House
Berneslai Close Barnsley
S70 2FL
T: 01226 286256
M: 07881898300
E: mboothdesign@btconnect.com

Scale	As Shown @ A2	Drawn	MJB
Date	October 2018	Ref.	18.22
Dwg No.	P01	Rev.	C

0cm 2cm 4cm 6cm

Copyright mboothdesign. All dimensions in millimeters unless otherwise stated. Dimensions for setting out in existing buildings are to be checked and verified on site.