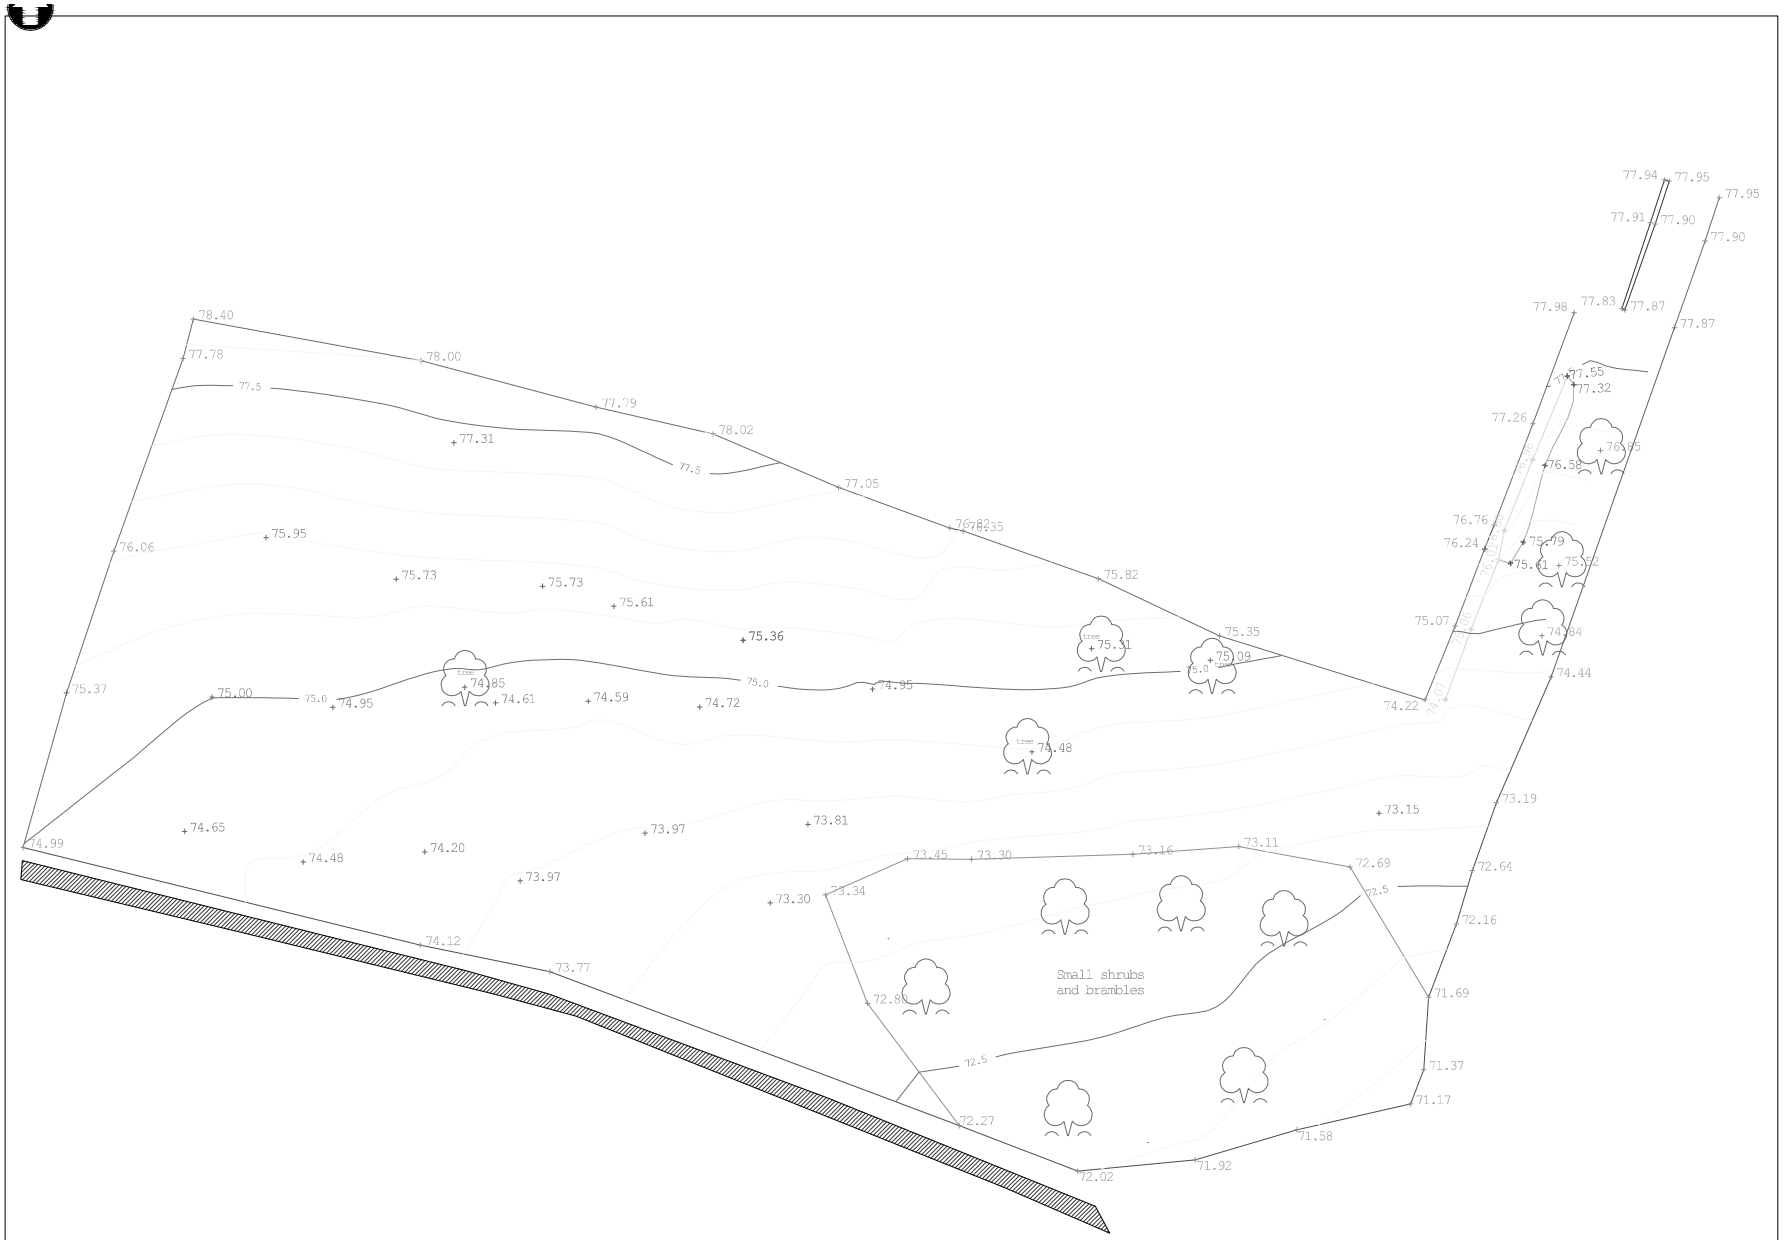

Key to symbols

- Existing Dyke
- Drainage Grid
- Concrete Wall
- Fence Line
- Tree Line
- Top Of Batter
- Bottom Of Batter
- Existing Back Garden Boundary

Reference drawings

A8			As Built Issue		
Rev	Date	Drawn	Description	Ch'k'd	App'd

Client

Title

Knowles Street
Topographical Survey
Land Survey

Designed			Eng.Chk.		
Drawn	c.kipling	ck	Coordination		
Dwg.Chk.			Approved		
Scale at A1	Project RB001				Status
	CAD file				
Drawing No Knowless Street Topo 001					Rev